

ADDENDUM NO. 1

FOR

BARNEY POND DAM – PEDESTRIAN BRIDGE RFP 2013-22 JUNE 3, 2013

NOTICE TO PROSPECTIVE BIDDERS

Prospective bidders are hereby informed of the following corrections, additions, deletions, and/or modifications to the bidding documents for the Barney Pond Dam – Pedestrian Bridge project. This Addendum No. 1 forms a part of the bidding documents and all changes shall be incorporated into the Bid Proposals. This Addendum No. 1 shall be noted as acknowledged by returning the Addendum Acknowledgment Receipt provided at the end of this Addendum. Bidders shall also acknowledge receipt of this addendum on the line provided on the revised Bid Form provided as Exhibit A to this Addendum No. 1. **Bidders who fail to acknowledge receipt of this Addendum No. 1 on the revised Bid Form provided as Exhibit A to this Addendum No. 1 will not be considered for award.**

Part 1 – Responses to Questions

The following questions were received in writing, or verbally during the pre-bid meeting, from prospective bidders by end of day on May 30, 2013. The questions are italicized and the answers follow.

- 1. The Measurement and Payment Specifications lists the unit of measure as lump sum for the Pedestrian Bridge. The Bid Form lists the unit of measure as linear foot. Please clarify.*

The unit of measure for the Pedestrian Bridge is lump sum. The lump sum cost shall cover a bridge span ranging from 56 feet to 60 feet. A revised Bid Form is provided as Exhibit A to this Addendum No. 1.

- 2. Is there a completion date?*

The completion date shall be August 30, 2013. The start date shall be July 1, 2013.

3. *Are there any liquidated damages?*

No.

4. *Are any permits required?*

To the best of our knowledge, no permits are required.

5. *Are there any quality control testing requirements?*

Concrete shall be tested by an independent testing agency qualified according to ASTM C 1077 and ASTM E 329 to conduct the testing indicated, as documented according to ASTM E 548. Personnel conducting field tests shall be qualified as ACI Concrete Field Testing Technician, Grade 1, according to ACI CP-1 or an equivalent certification program. The required concrete tests are as follows:

- Slump Test in accordance with ASTM C 143. One test at each point of placement. One additional test for each pour exceeding 50 cubic yards.
- Air Content Test in accordance with AASHTO T 199-00 or ASTM C231, pressure method. One test at each point of placement. One additional test for each pour exceeding 50 cubic yards.
- Concrete Temperature Test in accordance with ASTM C 1064. One test hourly when air temperature is 40°F and below or when 80°F and above. One test at each point of placement.
- Compression Test Specimens shall be in accordance with ASTM C 31/C 31M; cast and laboratory cure one set of four standard cylinder specimens for each day of placement.
 - Cast and field cure one set of four standard cylinder specimens for each day of placement.
- Compressive Strength Test in accordance with ASTM C39.
 - Test two laboratory-cured specimens at 7 days and two at 28 days.
 - Test two field-cured specimens at 7 days and two at 28 days.
 - A compressive-strength test shall be the average compressive strength from two specimens obtained from same composite sample and tested at age indicated.

The existing subgrade and/or gravel borrow below the concrete footings and landing shall be tested as follows by a an independent testing agency holding current certification with the State of Rhode Island:

- Sieve analysis in accordance with ASTM D422
- Modified proctor analysis in accordance with ASTM D 1557
- Soil compaction tests (nuclear density) in accordance with ASTM D 6938

6. *Is there a concrete strength requirement for the concrete footings?*

The licensed professional engineer designing the concrete footings is responsible for specifying the minimum concrete strength.

7. *Is funding in place for this project?*

Yes.

8. *Is there an engineer's estimate for this project?*

No.

9. *Are there any physical restrictions at the site? Do trees need to be cleared to access the site?*

All bidders should visit the site to evaluate physical restrictions at the site. Trees should not need to be cleared. There is a temporary guardrail along the edges of the dam that will be removed prior to construction.

10. *What will the working hours be?*

Weekday working hours shall be 7:30am to 4:00pm.

11. *Will construction be allowed during the weekend?*

Weekend work will only be allowed if preapproved by the Town. It will not be allowed on a regular basis.

12. *Is there any geotechnical information available for use to design the footings?*

Subsurface boring logs are provided as Exhibit C to this Addendum No. 1. The provided boring information was specific to a separate project at Barney Pond Dam and were not completed for this project. Bidders shall verify the applicability of the provided information. The cost of additional geotechnical evaluations shall be incorporated into the lump sum bid price for the Pedestrian Bridge (Bid Item 2) if deemed necessary by the bidder.

13. *Is the existing concrete along the edge of the dam sufficient to act as the footing?*

The existing concrete has not been evaluated to determine if it is sufficient.

14. *The bid documents list a bridge span of 56 feet. Will the concrete footings be on top of or beyond the existing concrete along the edge of the dam?*

The length listed in the bidding documents assumes the footings will be located beyond the concrete wall; however the final location of the footings shall be determined by the selected bidders. The span of the dam (measured from the inside of the concrete on both sides) is approximately 50 feet. As stated in the response question 1, the lump sum cost for the pedestrian bridge shall cover a bridge span ranging from 56 feet to 60 feet.

15. *Would the Town consider driving piles with a concrete cap rather than a concrete footing?*

No.

16. *Will the existing building remain?*

Yes, the existing building is the gatehouse for the dam. The building must remain in place and not be damaged. The Contractor shall be responsible for any damage that occurs to the building as a result of construction.

17. *What elevation do you want the bridge to be at on each side of the dam?*

As shown on the plans, the existing elevation at both sides of the dam is approximately 76.5. The bridge shall match into this grade.

18. *Are onsite staging and stockpile areas available?*

Yes, onsite staging and stockpiling areas are available. The locations for staging and stockpiling will be determined during the pre-construction meeting.

19. *Is traffic control required?*

Bidders shall evaluate the work and determine if flaggers and/or a police detail is required. Cost for traffic control, if determined necessary, shall be included in the Mobilization and Demobilization bid item.

20. *The bid form includes a \$20,000 allowance. What is the allowance for?*

The allowance is a contingency allowance for work that the Owner may want to add to the contract. The allowance shall only be used at the Owner's sole discretion, in whole or in part. Work authorizing expenditures from the allowance shall only be executed by a Change Order. At contract closeout, any funds remaining in the allowance shall be credited to the Owner by a balancing Change Order.

21. *Will any other contractors be onsite during construction?*

No.

22. *What will the elevation of the concrete landing be?*

The finish elevation of the concrete landing shall match existing grade. Minor changes to the elevation may be made to ensure adequate drainage.

23. *What is to happen to the concrete wall near the northern edge of the concrete landing, in the area where the existing timber guardrail is to be removed?*

The wall, which consists of blocks and mortar, shall be removed by the contractor to create a flush surface for the concrete landing.

24. *How close will the bridge be to the existing building?*

The final location of the bridge will be determined in the field prior to construction. We intend for the bridge to be located very close to the building.

25. *Will the bridge be placed perpendicular to the walls or will it be angled? It appears that the bridge would need to be angled to avoid grading on the southern side of the dam.*

The bridge will be placed perpendicular with the final location to be determined in the field prior to construction. Earthwork will be required on the southern side of the dam to allow for the perpendicular installation and connection to the existing access path. Bidders shall assume an earthwork quantity of 60 cubic feet and include the cost of this in the lump sum bid price for the Pedestrian Bridge (Bid Item 2). A revised Measurement and Payment section is provided as Exhibit B to this Addendum No. 1.

26. *Will alternate bridges be considered?*

While the original bid documents stated that approved equals are acceptable, this Addendum removes the approved equal option. The bridge must be the Gatorbridge as specified on the plans and in the specifications.

27. *Has GatorBridge provided the Town with a price quote to be used for bidding?*

No. Bidders shall contact GatorBridge for pricing.

28. *Was hydropower considered for this bridge?*

No.

Part 2 – Amendments to Bid Documents

The following corrections, additions, deletions, and/or modifications shall be incorporated into the bidding documents and bid proposals.

1. As stated above, the lump sum bid price for the Pedestrian Bridge (Bid Item 2) shall include the cost for a bridge with a span ranging from 56 feet to 60 feet. A revised Measurement and Payment section is provided as Exhibit B to this Addendum No. 1.
2. As-Built Plans for the recently improved Dam Improvements are provided as Exhibit D to this Addendum No. 1.

EXHIBIT A

BID FORM

BARNEY POND DAM – PEDESTRIAN BRIDGE
RFP #2013-22
ADDENDUM NO. 1

BID FORM

BASE BID ITEMS

Bid Item No.	Description	Unit	Quantity	Unit Price (Figures)	Extended Bid Price (Figures)
1.	Mobilization and Demobilization	LS	1	\$	\$
Extended Bid Price in Words:					
2.	Pedestrian Bridge	LS	1	\$	\$
Extended Bid Price in Words:					
3.	Concrete Landing	SY	38	\$	\$
Extended Bid Price in Words:					
4.	Railing	LF	24	\$	\$
Extended Bid Price in Words:					
5.	Stone Dust Parking Area	SY	40	\$	\$
Extended Bid Price in Words:					
6.	Owner's Allowance	LS	1	\$20,000	\$20,000
Extended Bid Price in Words:					

FOR PURPOSES OF BID COMPARISON, TOTAL BASE BID PRICE FOR BID ITEMS 1 THROUGH 6:

\$ _____ (Amount in Figures)

\$ _____ (Amount in Words)

Base Bid Item 6 is a stated allowance to be carried by all bidders and shall be utilized solely at the discretion and authorization of the Owner. There shall be no markup for profit or overhead for items covered under the allowance. Any and all unused portions of the monies allocated to the allowance shall be refunded to the Owner via change order.

In submitting this Bid, Bidder represents the following:

- A. The above prices include all labor, materials, tools, equipment, overhead, profit, insurances, etc. to cover the finished work of the several kinds called for.
- B. Bidder has examined and carefully studied the Bidding Documents, and the following Addenda, receipt of which is hereby acknowledged.

Addendum No.	Addendum Date
_____	_____
_____	_____
_____	_____
_____	_____

- C. Bidder does not consider that any further examinations or information are necessary for the determination of this Bid.
- D. Bidder is aware of the general nature of work to be performed by the Owner and others at the Site that relates to the Work as indicated in the Bidding Documents.
- E. Bidder has given the Owner notice of all conflicts, errors, ambiguities, or discrepancies that Bidder has discovered in the Bidding Documents, and the written resolution from the Owner is acceptable to Bidder.
- F. The Bidding Documents are sufficient to convey understanding of the performance of the Work for which this Bid is submitted.
- G. Bidder represents that this Bid is genuine and not made in the interest of or on behalf of any undisclosed individual or entity and is not submitted in conformity with any agreement or rules of any group, association, organization or corporation.
- H. Bidder has not directly or indirectly induced or solicited any other Bidder to submit a false or sham Bid
- I. Bidder has not solicited or induced any individual or entity to refrain from bidding.
- J. Bidder has not sought by collusion to obtain for itself any advantage over any other.

This Bid is submitted by:

Name of Authorized Representative _____

Title of Authorized Representative: _____

Signature of Authorized Representative: _____

Business Name _____

Business address: _____

Phone No.: _____ FAX No.: _____

State Contractor License No. _____

Seal (if bid is by Corporation):

SUBMITTED on _____, 2013 .

EXHIBIT B

MEASUREMENT AND PAYMENT

BARNEY POND DAM – PEDESTRIAN BRIDGE
RFP #2013-22
ADDENDUM NO. 1

MEASUREMENT AND PAYMENT

SUMMARY

This Section includes measurement and payment paragraphs for:

- A. Base Bid Payment Items

DEFINITIONS

- A. Payment Items: The Owner's distribution of the Contract Sum through listed work items.
 - 1. Each item is specified to include a defined scope of services. However, not all materials, labor, equipment, or services of a payment item are guaranteed to be listed or specified.
 - 2. Include costs associated with items of work required to complete the defined scope of services within the appropriately specified payment item.
 - 3. Payment items include furnishing all necessary material, plus cost for delivery, installation, applicable taxes and fees, administrative over-site, tools, labor, incidentals, overhead, and profit.
 - 4. All work described in the Contract Documents shall be included in the payment items described herein.
 - 5. Unit bid alternate price items will only be incorporated into the project if selected and authorized in writing by the Owner.
- B. Unit Price: An amount incorporated in the Agreement, applicable during the duration of the Work as a price per unit of measurement for materials, equipment, or services, or a portion of the Work, added to or deducted from the Contract Sum by appropriate modification, if the scope of Work or estimated quantities of Work required by the Contract Documents are increased or decreased.
- C. Lump Sum: When used as an item of payment, means complete payment for the work prescribed for that portion of the Work under the item, or all work prescribed in the Contract, as the case may be.
- D. Complete In Place: When used in the measurement and payment provisions, means the completion of the contract item, including the furnishing of all materials, equipment, tools, labor, health and safety requirements, and work incidental thereto
- E. Payment for Work associated with individual Work Segments will not be released until such Work Segment is Substantially Complete, including site restoration and site improvements of that Work Segment and has been approved as such by the Owner or Engineer.

PROCEDURES

- A. Unit prices and lump sum items include furnishing all necessary material, plus cost for delivery, installation, insurance, applicable taxes, overhead, and profit.
- B. Measurement: Notify Owner at least 48 working hours prior to the time at which necessary measurements must be taken. Notification must be in advance of obscuring pay item; do not proceed until such measurements have been taken in the presence of the Owner.

LIST OF BASE BID PAYMENT ITEMS

- A. The payment items listed below identify the major components of work identified and specified in the Contract Documents. Work that is not specifically called out within an individual payment item but is inherently required to complete the Work shall be considered as a part of that payment item

Bid Item 1: Mobilization and Demobilization

- 1. Mobilization and Demobilization includes, but is not limited to, the following:
 - a. Mobilization of all equipment, materials, temporary facilities/controls, and other items necessary to complete the Work to the Site.
 - b. Installation, maintenance, and removal of sediment and erosion controls.
 - c. Site restoration including furnishing loam and seed in all disturbed areas.
 - d. Demobilization of all equipment, materials, temporary facilities/controls.
 - e. Other items mobilized to the site for execution of the Work.
 - f. Bonds and General Condition requirements.
- 2. Measurement: As measured by the Owner. Contractor will be paid 50% upon completion of mobilization, which includes the installation of sediment and erosion controls, and the remaining 50% upon completion of demobilization from the site, which includes the removal and disposal of sediment and erosion controls and establishment of vegetation.
- 3. Payment: Mobilization and Demobilization will be paid for on a Lump Sum basis, complete in place.

Bid Item 2: Pedestrian Bridge

- 1. Pedestrian Bridge includes, but is not limited to, the following:
 - a. Removing and stockpiling existing timber guard rail.
 - b. Designing and constructing footings for Pedestrian Bridge.
 - c. Furnishing and installing Pedestrian Bridge with railing. Span of pedestrian bridge shall be between 56 feet and 60 feet with the final length determined in the field.
 - d. 60 cubic yards of earthwork on the southern side of the dam to extend the existing access path to the east for connection to the pedestrian bridge.

2. Measurement: As measured by the Owner, pro-rated with the Contractor's progress of installing the pedestrian bridge, complete in place.
3. Payment: Pedestrian Bridge will be paid for on a Lump Sum basis, complete in place.

Bid Item 3: Concrete Landing

1. Concrete Landing includes, but is not limited to, the following:
 - a. Excavating and fine grading
 - b. Furnishing, placing, fine grading, and compacting gravel borrow.
 - c. Furnishing and installing concrete landing including forms, concrete, expansion joints, and finishing the concrete.
 - d. Removing & disposing of surplus material.
2. Measurement: As measured by the Owner, per square yard of constructed concrete landing.
3. Payment: Concrete Landing will be paid for per square yard of constructed concrete landing, as shown on the Contract Drawings, or as directed and approved in the field.

Bid Item 4: Railing

1. Railing includes, but is not limited to, the following:
 - a. Furnishing and installing posts, rails, hasps, hardware, and appurtenances.
 - b. Attaching railing to concrete landing with manufacturer provided base plates.
 - c. Backfilling excavations.
2. Measurement: As measured by the Owner per linear foot of railing installed, complete in place.
3. Payment: Railing will be paid per linear foot of perimeter railing installed, as shown on the Contract Drawings, or as directed and approved in the field.

Bid Item 5: Stone Dust Parking Area

1. Stone Dust Parking Area includes, but is not limited to, the following:
 - a. Furnishing, placing, shaping, and compacting gravel borrow.
 - b. Furnishing, placing, shaping, and compacting stone dust.
2. Measurement: As measured by the Owner per square yard of stone dust installed, complete in place.
3. Payment: Stone Dust Parking Area will be paid per square yard of stone dust installed, as shown on the Contract Drawings, or as directed and approved in the field.

EXHIBIT C

GEOTECHNICAL INFORMATION

PARE CORPORATION							BORING NO. <u>B12-1</u>			
10 LINCOLN ROAD, SUITE 103, FOXBORO, MASSACHUSETTS										
ENGINEERS *** PLANNERS *** CONSULTANTS							SHEET <u>1</u> OF <u>2</u>			
PROJECT <u>Barney Pond Dam</u> <u>Lincoln, RI</u>				PROJECT NO. <u>8194.01</u>		CHKD. BY <u>DMM</u>				
BORING CO. <u>New Hampshire Boring</u>			BORING LOCATION <u>SEE EXPLORATION LOCATION PLAN</u>							
FOREMAN <u>Chris Knight</u>			GROUND SURFACE ELEVATION <u>76</u>		DATUM <u>NGVD 29</u>					
INSPECTOR <u>J. Rosenberg</u>			DATE START <u>1/24/2012</u>		DATE END <u>1/24/2012</u>					
SAMPLER: UNLESS OTHERWISE NOTED, SAMPLER CONSISTS OF A 2" SPLIT SPOON DRIVEN USING A 140 lb. HAMMER FALLING 30 in.				GROUNDWATER READINGS						
CASING: UNLESS OTHERWISE NOTED, CASING DRIVEN USING 300 lb. HAMMER FALLING 24 IN.				DATE	TIME	WATER AT	CASING AT	STABILIZATION TIME		
CASING SIZE: <u>4"</u> OTHER:				1/23/12	12:30	13'	40'			
DEPTH (ft)	CASING (bwt)	SAMPLE					SAMPLE DESCRIPTION		REMARKS	STRATUM DESCRIPTION
		NO.	PEN. (in.)/ REC.	DEPTH (FT)	BLOWS/6"	TONS/FT ² OR KG/CM ²	Burmister	CLASSIFICATION		
5									1.	
10									2.	
15										
20		S-1	24/8	19-21	4 4 4 4		Wet, loose, tan, fine to medium SAND, trace coarse sand and fine gravel, trace silt.			
25		S-2	24/12	24-26	3 6 16 18		Wet, medium dense, gray/tan, fine to medium SAND, trace coarse sand, trace silt.			SAND
30		S-3	24/16	29-31	12 15 12 15		Wet, medium dense, gray, fine SAND, trace silt.		3.	
GRANULAR SOILS		COHESIVE SOILS		REMARKS:						
BLOWS/FT	DENSITY	BLOWS/FT	DENSITY	1. Safety hammer.			BURMISTER CLASSIFICATION			
0 - 4	V. LOOSE	<2	V.SOFT	2. No sampling was completed from the surface to 19 feet.			TRACE 0 - 10%			
4 - 10	LOOSE	2 - 4	SOFT	3. 28' possible small boulders/cobbles above fine sand.			LITTLE 10 - 20%			
10 - 30	M.DENSE	4 - 8	M.STIFF				SOME 20 - 35%			
30 - 50	DENSE	8 - 15	STIFF				AND 35 - 50%			
>50	V.DENSE	15 - 30	V.STIFF				PERCENT BY WEIGHT			
		>30	HARD							
NOTES: 1) THE STRATIFICATION LINES REPRESENT THE APPROXIMATE BOUNDARY BETWEEN SOIL TYPES, TRANSITIONS MAY BE GRADUAL. 2) WATER LEVEL READINGS HAVE BEEN MADE IN THE DRILL HOLES AT TIMES AND UNDER CONDITIONS STATED ON THE BORING LOGS. FLUCTUATIONS IN THE LEVEL OF GROUNDWATER MAY OCCUR DUE TO OTHER FACTORS THAN THOSE PRESENT AT THE TIME MEASUREMENTS WERE MADE.										
							BORING NO. B12-1			

PARE CORPORATION
 10 LINCOLN ROAD, SUITE 103, FOXBORO, MASSACHUSETTS
 ENGINEERS *** PLANNERS *** CONSULTANTS

BORING NO. B12-1

SHEET 2 OF 2

PROJECT Barney Pond Dam
Lincoln, RI

PROJECT NO. _____
 CHKD. BY _____

8194:01
DMM

DEPTH (FT)	CASING (BMT)	SAMPLE					SAMPLE DESCRIPTION	REMARKS	STRATUM DESCRIPTION
		NO.	PEN. (in.)/ REC.	DEPTH (FT)	BLOWS/6"	TONS/FT ² OR KG/CM ²			
35		S-4	24/20	34-36	8 11 13 17		Wet, medium dense, gray/tan, SILT, some clay, trace to little fine sand.		SAND
40		S-5	24/15	39-41	9 13 10 12		Wet, medium dense, gray, SILT, some fine SAND.		SILT
45		S-6	24/16	44-46	14 15 20 28		Wet, dense, tan, SILT, some fine SAND.		
50		S-7	24/0	49-51	50 90 100/4"		No recovery. END OF EXPLORATION @ 50'4".	3.	
55									
60									
65									
70									

GRANULAR SOILS		COHESIVE SOILS		REMARKS:	BURMISTER CLASSIFICATION
BLOWS/FT	DENSITY	BLOWS/FT	DENSITY		
0 - 4	V. LOOSE	<2	V.SOFT	3. Possible pushing cobble.	TRACE 0 - 10%
4 - 10	LOOSE	2 - 4	SOFT		LITTLE 10 - 20%
10 - 30	M.DENSE	4 - 8	M.STIFF		SOME 20 - 35%
30 - 50	DENSE	8 - 15	STIFF		AND 35 - 50%
>50	V.DENSE	15 - 30	V.STIFF		PERCENT BY WEIGHT
		>30	HARD		

NOTES: 1) THE STRATIFICATION LINES REPRESENT THE APPROXIMATE BOUNDARY BETWEEN SOIL TYPES, TRANSITIONS MAY BE GRADUAL.
 2) WATER LEVEL READINGS HAVE BEEN MADE IN THE DRILL HOLES AT TIMES AND UNDER CONDITIONS STATED ON THE BORING LOGS. FLUCTUATIONS IN THE LEVEL OF GROUNDWATER MAY OCCUR DUE TO OTHER FACTORS THAN THOSE PRESENT AT THE TIME MEASUREMENTS WERE MADE.

BORING NO. B12-1

PARE CORPORATION							BORING NO. <u>B12-2</u>		
10 LINCOLN ROAD, SUITE 103, FOXBORO, MASSACHUSETTS									
ENGINEERS ***			PLANNERS ***		CONSULTANTS		SHEET <u>1</u> OF <u>2</u>		
PROJECT <u>Barney Pond Dam</u> <u>Lincoln, RI</u>				PROJECT NO. <u>8194.01</u>		CHKD. BY <u>DMM</u>			
BORING CO. <u>New Hampshire Boring</u>			BORING LOCATION <u>SEE EXPLORATION LOCATION PLAN</u>						
FOREMAN <u>Chris Knight</u>			GROUND SURFACE ELEVATION <u>76.7</u>			DATUM <u>NGVD 29</u>			
INSPECTOR <u>J. Rosenberg</u>			DATE START <u>1/24/2012</u>			DATE END <u>1/24/2012</u>			
SAMPLER: UNLESS OTHERWISE NOTED, SAMPLER CONSISTS OF A 2" SPLIT SPOON DRIVEN USING A 140 lb. HAMMER FALLING 30 in.					GROUNDWATER READINGS				
CASING: UNLESS OTHERWISE NOTED, CASING DRIVEN USING 300 lb. HAMMER FALLING 24 IN.					DATE	TIME	WATER AT	CASING AT	STABILIZATION TIME
CASING SIZE: <u>4"</u> OTHER:					<u>1/24/12</u>	<u>1:00</u>	<u>9'</u>	<u>34'</u>	
DEPTH (ft)	CASING (ft)	SAMPLE				SAMPLE DESCRIPTION		REMARKS	STRATUM DESCRIPTION
		NO.	PEN. (in./REC.)	DEPTH (FT)	BLOWS/6"	TONS/FT ² OR KG/CM ²	Burmister		
5									
10									
15									
20		S-1	24/4	19-21	13 4 5 8		Wet, loose, tan, fine to medium SAND, trace silt, trace coarse sand and gravel.	1.	SAND
25		S-2	24/12	24-26	20 25 32 42		Wet, very dense, tan, fine to medium SAND, some silt, trace fine gravel.	2. 3.	
30		S-3	24/16	29-31	44 45 43 37		Moist/wet, very dense, light brown/orange SILT, some fine to medium sand, trace coarse sand and gravel.	4. 5.	SILT
GRANULAR SOILS		COHESIVE SOILS		REMARKS:					
BLOWS/FT	DENSITY	BLOWS/FT	DENSITY	1. Safety hammer.					
0 - 4	V. LOOSE	<2	V.SOFT	2. No sampling was performed from the surface to 19 feet.					
4 - 10	LOOSE	2 - 4	SOFT	3. Possible boulder 25'-28', mottling/orange staining @ tip.					
10 - 30	M.DENSE	4 - 8	M.STIFF	4. Hard drilling 26'-27' (smooth),					
30 - 50	DENSE	8 - 15	STIFF	5. Difficult to remove spoon from hole.					
>50	V.DENSE	15 - 30	V.STIFF						
		>30	HARD						
								BURMISTER CLASSIFICATION	
								TRACE	0 - 10%
								LITTLE	10 - 20%
								SOME	20 - 35%
								AND	35 - 50%
								PERCENT BY WEIGHT	
NOTES: 1) THE STRATIFICATION LINES REPRESENT THE APPROXIMATE BOUNDARY BETWEEN SOIL TYPES, TRANSITIONS MAY BE GRADUAL. 2) WATER LEVEL READINGS HAVE BEEN MADE IN THE DRILL HOLES AT TIMES AND UNDER CONDITIONS STATED ON THE BORING LOGS. FLUCTUATIONS IN THE LEVEL OF GROUNDWATER MAY OCCUR DUE TO OTHER FACTORS THAN THOSE PRESENT AT THE TIME MEASUREMENTS WERE MADE.									
								BORING NO. B12-2	

PARE CORPORATION

10 LINCOLN ROAD, SUITE 103, FOXBORO, MASSACHUSETTS
ENGINEERS * PLANNERS *** CONSULTANTS**

BORING NO. B12-2

SHEET 2 OF 2

PROJECT: Barney Pond Dam
Lincoln, RI

PROJECT NO. _____
 CHKD. BY _____

8194.01
 DMM

DEPTH (ft)	CASING (b/hr)	SAMPLE					SAMPLE DESCRIPTION	REMARKS	STRATUM DESCRIPTION
		NO.	PEN. (in./REC.)	DEPTH (FT)	BLOWS/6"	TONS/FT ² OR KG/CM ²			
35		S-4	16/12	34-36	60 90 100/4"	Moist, very dense, white/gray, SILT and WEATHERED ROCK.	6.	SILT AND WEATHERED ROCK	
40		S-5	24/12	39-41	25 27 26 100/5"	Wet, dense, fine to medium SAND and SILT, trace fine gravel.	7.	SAND AND SILT	
45		S-6	0/0	41	100/0	No recovery.	8.		
		C-1	60/60	46.	8 Min 8 Min 6.5 Min 6 Min	RQD = 56%. Light gray Granite BEDROCK	9.	GRANITE BEDROCK	
50					6 Min				
						END OF EXPLORATION @ 51.5'.			
55									
60									
65									
70									

GRANULAR SOILS		COHESIVE SOILS		REMARKS:	BURMISTER CLASSIFICATION
BLOWS/FT	DENSITY	BLOWS/FT	DENSITY		
0 - 4	V. LOOSE	<2	V.SOFT	6. Cobbles at top.	TRACE 0 - 10%
4 - 10	LOOSE	2 - 4	SOFT	7. Cobble in tip.	LITTLE 10 - 20%
10 - 30	M.DENSE	4 - 8	M.STIFF	8. Very fine @43', boulder seam,	SOME 20 - 35%
30 - 50	DENSE	8 - 15	STIFF	9. 46'5 very hard	AND 35 - 50%
>50	V.DENSE	15 - 30	V.STIFF		PERCENT BY WEIGHT
		>30	HARD		

NOTES: 1) THE STRATIFICATION LINES REPRESENT THE APPROXIMATE BOUNDARY BETWEEN SOIL TYPES, TRANSITIONS MAY BE GRADUAL.
 2) WATER LEVEL READINGS HAVE BEEN MADE IN THE DRILL HOLES AT TIMES AND UNDER CONDITIONS STATED ON THE BORING LOGS. FLUCTUATIONS IN THE LEVEL OF GROUNDWATER MAY OCCUR DUE TO OTHER FACTORS THAN THOSE PRESENT AT THE TIME MEASUREMENTS WERE MADE.

BORING NO. **B12-2**

PROJECT Barney's Pond Dam PROJECT NO. 06145.01
Lincoln, RI CHKD. BY _____

BORING CO. Soil Exploration Corp. BORING LOCATION SEE EXPLORATION LOCATION PLAN
 FOREMAN Don Ledger GROUND SURFACE ELEVATION 76.0' DATUM _____
 ENGINEER V. Luzzi DATE START 1/19/2007 DATE END 1/19/2007

SAMPLER: UNLESS OTHERWISE NOTED, SAMPLER CONSISTS OF A 2" SPLIT SPOON DRIVEN USING A 140 lb. HAMMER FALLING 30 in.
 CASING: UNLESS OTHERWISE NOTED, CASING DRIVEN USING 300 lb. HAMMER FALLING 24 IN.
 CASING SIZE: _____ OTHER: 4 1/4" HSA

GROUNDWATER READINGS				
DATE	TIME	WATER AT	CASING AT	STABILIZATION TIME
1/19	10:30	6'	Out	End of Boring

DEPTH (FT)	CASING (BUR)	SAMPLE				TONS/FT ² OR KG/CM ²	SAMPLE DESCRIPTION	REMARKS	STRATUM DESCRIPTION
		NO.	PEN. (in.) REC.	DEPTH (FT)	BLOWS/6"				
		S-1	24/5	0-2	5 4		Moist, loose, tan, fine to medium SAND, trace (+) silt, trace gravel.		MISCELLANEOUS GRANULAR FILL
		S-2	24/12	2-4	6 8		Moist, medium dense, tan, fine to medium SAND, trace (+) silt.		
5		S-3	24/12	4-6	5 4		Moist to wet, loose, tan, fine to medium SAND, trace (+) silt, trace (-) gravel.		SILTY SAND FILL
		S-4	24/18	6-8	7 2		Wet, very loose, tan, fine to medium SAND, trace (+) silt.		
		S-5	24/2	8-10	3 11		Wet, medium dense, gray, fine SAND, some silt.		FINE SAND
10		S-6	24/10	10-12	2 1		Wet, very loose, gray, fine SAND, some silt, trace (-) fine angular gravel.		
		S-7	24/22	12-14	7 10		Wet, medium dense, gray, fine SAND, little silt, little angular gravel.		
15		S-8	13/6	15-16'1"	12 19		Wet, very dense, gray, fine SAND, little angular gravel, trace (+) silt.		
					100/1"				
20		S-9	24/18	20-22	35 28		Wet, very dense, gray, fine SAND, little angular gravel, trace (+) silt.		
					39 37				
25							END OF EXPLORATION AUGER REFUSAL @ 24'.	1.	
30									

GRANULAR SOILS		COHESIVE SOILS		REMARKS:	BURMISTER CLASSIFICATION
BLOWS/FT	DENSITY	BLOWS/FT	DENSITY		
0 - 4	V. LOOSE	<2	V.SOFT	1. Auger refusal @ 24'. 2. Boring grouted to surface upon completion.	TRACE 0 - 10%
4 - 10	LOOSE	2 - 4	SOFT		LITTLE 10 - 20%
10 - 30	M.DENSE	4 - 8	M.STIFF		SOME 20 - 35%
30 - 50	.DENSE	8 - 15	STIFF		AND 35 - 50%
>50	V.DENSE	15 - 30	V.STIFF		PERCENT BY WEIGHT
		>30	HARD		

PROJECT Barney's Pond Dam PROJECT NO. 06145.01
Lincoln, RI CHKD. BY _____

BORING CO. Soil Exploration Corp. BORING LOCATION SEE EXPLORATION LOCATION PLAN
 FOREMAN George Guinto GROUND SURFACE ELEVATION 76.12' DATUM _____
 ENGINEER P. Manor DATE START 1/19/2007 DATE END 1/19/2007

SAMPLER: UNLESS OTHERWISE NOTED, SAMPLER CONSISTS OF A 2" SPLIT SPOON DRIVEN USING A 140 lb. HAMMER FALLING 30 in.
 CASING: UNLESS OTHERWISE NOTED, CASING DRIVEN USING 300 lb. HAMMER FALLING 24 IN.
 CASING SIZE: _____ OTHER: 4 1/4" HSA

GROUNDWATER READINGS				
DATE	TIME	WATER AT	CASING AT	STABILIZATION TIME
1/19	12:45	6.0±	Out	End of Boring

DEPTH (FT)	CASING (ID)	SAMPLE				TONS/FT ² OR KG/CM ²	SAMPLE DESCRIPTION	REMARKS	STRATUM DESCRIPTION
		NO.	PEN. (in.) / REC.	DEPTH (FT)	BLOWS/6"				
5		S-1	24/6	0-2	11 12		Moist, medium dense, brown fine to medium SAND, little gravel, little silt.		MISCELLANEOUS GRANULAR FILL
					13 15				
5		S-2	24/2	2-4	22 16		Moist, medium dense, brown fine to medium SAND, little silt, trace gravel.		
					14 15				
5		S-3	24/19	4-6	5 4		Moist, loose, tan fine to medium SAND, little gravel, trace silt.		
					4 7				
5		S-4	24/16	6-8	5 2		Wet, very loose, tan fine to medium SAND and SILT, some gravel.		
					2 7				
10		S-5	24/5	8-10	3 7		Wet, medium dense, tan fine SAND and SILT, trace gravel.		SILTY SAND FILL
					9 10				
10		S-6	24/1	10-12	2 4		Wet, medium dense, cobble in tip.		
					6 4				
15		S-7	24/14	12-14	4 5		Wet, loose, tan fine SAND and SILT, trace gravel, changing to gray fine SAND and SILT, trace organics.		ORGANIC SAND & SILT
					4 3				
15		S-8	24/10	15-17	3 4		Wet, medium dense, gray fine SAND and SILT, trace organics.		
					6 7				
20		S-9	24/20	20-22	3 2		Wet, very loose, gray fine to medium SAND, little silt.		FINE TO MEDIUM SAND
					2 3				
25		S-10	24/10	25-27	8 8		Wet, medium dense, gray fine to medium SAND, little coarse sand, trace silt.		
					10 9				
30		S-11	24/12	30-32	17 10		Wet, medium dense, gray fine SAND, trace silt.		FINE SAND
					8 17				

GRANULAR SOILS		COHESIVE SOILS		REMARKS:	BURMISTER CLASSIFICATION
BLOWS/FT	DENSITY	BLOWS/FT	DENSITY		
0 - 4	V. LOOSE	<2	V.SOFT		TRACE 0 - 10%
4 - 10	LOOSE	2 - 4	SOFT		LITTLE 10 - 20%
10 - 30	M.DENSE	4 - 8	M.STIFF		SOME 20 - 35%
30 - 50	DENSE	8 - 15	STIFF		AND 35 - 50%
>50	V.DENSE	15 - 30	V.STIFF		PERCENT BY WEIGHT
		>30	HARD		

NOTES: 1) THE STRATIFICATION LINES REPRESENT THE APPROXIMATE BOUNDARY BETWEEN SOIL TYPES, TRANSITIONS MAY BE GRADUAL.
 2) WATER LEVEL READINGS HAVE BEEN MADE IN THE DRILL HOLES AT TIMES AND UNDER CONDITIONS STATED ON THE BORING LOGS. FLUCTUATIONS IN THE LEVEL OF GROUNDWATER MAY OCCUR DUE TO OTHER FACTORS THAN THOSE PRESENT AT THE TIME MEASUREMENTS WERE MADE.

BORING NO. B-3

PROJECT Barney's Pond Dam
Lincoln, RI

PROJECT NO. _____
 CHKD. BY _____

06145.01

DEPTH (ft)	CASING (birt)	SAMPLE					TONS/FT ² OR KG/CM ²	SAMPLE DESCRIPTION	REMARKS	STRATUM DESCRIPTION
		NO.	PEN. (in./REC.)	DEPTH (FT)	BLOWS/6"					
35		S-12	24/13	35-37	6 7 7 8		Wet, medium dense, gray fine SAND, trace silt.	1.	FINE SAND	
							END OF EXPLORATION @ 37'.			
40										
45										
50										
55										
60										
65										
70										

GRANULAR SOILS		COHESIVE SOILS		REMARKS:	BURMISTER CLASSIFICATION	
BLOWS/FT	DENSITY	BLOWS/FT	DENSITY			
0 - 4	V. LOOSE	<2	V.SOFT	1. 2" dia. Pvc monitoring well installed to a depth of 15', 5' screen, 10' riser, 2' bentonite seal, grouted to surface and roadway box installed.	TRACE	0 - 10%
4 - 10	LOOSE	2 - 4	SOFT		LITTLE	10 - 20%
10 - 30	M.DENSE	4 - 8	M.STIFF		SOME	20 - 35%
30 - 50	DENSE	8 - 15	STIFF		AND	35 - 50%
>50	V.DENSE	15 - 30	V.STIFF			PERCENT BY WEIGHT
		>30	HARD			

NOTES:
 1) THE STRATIFICATION LINES REPRESENT THE APPROXIMATE BOUNDARY BETWEEN SOIL TYPES. TRANSITIONS MAY BE GRADUAL.
 2) WATER LEVEL READINGS HAVE BEEN MADE IN THE DRILL HOLES AT TIMES AND UNDER CONDITIONS STATED ON THE BORING LOGS. FLUCTUATIONS IN THE LEVEL OF GROUNDWATER MAY OCCUR DUE TO OTHER FACTORS THAN THOSE PRESENT AT THE TIME MEASUREMENTS WERE MADE.

PROJECT Barney's Pond Dam PROJECT NO. 06145.01
Lincoln, RI CHKD. BY _____

BORING CO. Soil Exploration Corp. BORING LOCATION SEE EXPLORATION LOCATION PLAN
 FOREMAN Don Ledger GROUND SURFACE ELEVATION 75.40' DATUM _____
 ENGINEER V. Luzzi DATE START 1/19/2007 DATE END 1/19/2007

SAMPLER: UNLESS OTHERWISE NOTED, SAMPLER CONSISTS OF A 2" SPLIT SPOON DRIVEN USING A 140 lb. HAMMER FALLING 30 in.
 CASING: UNLESS OTHERWISE NOTED, CASING DRIVEN USING 300 lb. HAMMER FALLING 24 in.
 CASING SIZE: _____ OTHER: 4 1/4" HSA

GROUNDWATER READINGS				
DATE	TIME	WATER AT	CASING AT	STABILIZATION TIME
1/19	8:30	6'	Out	End of Boring

DEPTH (FT)	CASING (D/BY)	SAMPLE					SAMPLE DESCRIPTION	REMARKS	STRATUM DESCRIPTION
		NO.	PEN. (n./y) REC.	DEPTH (FT)	BLOWS/6"	TONS/FT ² OR KG/CM ²			
		S-1	24/18	0-2	10 13		Loose, medium dense, brown/tan, fine to medium SAND, trace (+) silt, trace (+) gravel.		MISCELLANEOUS GRANULAR FILL
		S-2	24/12	2-4	7 6		Moist, medium dense, tan, fine to medium SAND, trace (+) silt.		
5		S-3	24/8	4-6	14 8		Moist to wet, medium dense, tan, fine to medium SAND, some gravel, trace (+) silt.		
		S-4	24/12	6-8	5 5		Wet, medium dense, gray, fine to medium SAND, trace (+) silt.		
		S-5	24/5	8-10	5 5		Wet, medium dense, gray, fine to medium SAND, trace (+) silt.		
10		S-6	24/15	10-12	5 6		Wet, medium dense, gray, fine to medium SAND, trace (+) silt.		
		S-7	24/4	12-14	4 6		Wet, loose, gray, fine to medium SAND, trace (+) silt, trace (-) gravel.		
15		S-8	24/24	14-16	1 2		Wet, very loose, gray, fine to medium SAND, trace (+) silt.		
		S-9	24/24	16-18	3 3		Wet, loose, gray, fine to medium SAND, trace (+) gravel, trace (+) silt.		
20		S-10	24/6	20-22	1 4		Wet, medium dense, gray, fine to medium SAND, trace (-) gravel, trace (+) silt.		
					7 5				
25		S-11	24/24	25-27	7 14		Wet, dense, gray, fine to medium SAND, little (+) angular gravel, trace (-) gravel.		FINE TO MEDIUM SAND
					22 46				
30		S-12	24/24	30-32	10 6		Wet, medium dense, gray, fine SAND, trace silt.		FINE SAND
					6 7		END OF EXPLORATION @ 32'.		

GRANULAR SOILS		COHESIVE SOILS		REMARKS:	BURMISTER CLASSIFICATION
BLOWS/FT	DENSITY	BLOWS/FT	DENSITY		
0 - 4	V. LOOSE	<2	V.SOFT	1. Boring grouted to surface upon completion.	TRACE 0 - 10%
4 - 10	LOOSE	2 - 4	SOFT		LITTLE 10 - 20%
10 - 30	M.DENSE	4 - 8	M.STIFF		SOME 20 - 35%
30 - 50	DENSE	8 - 15	STIFF		AND 35 - 50%
>50	V.DENSE	15 - 30	V.STIFF		PERCENT BY WEIGHT
		>30	HARD		

BARNEY POND DAM IMPROVEMENTS
RIDEM ID: 0101
LINCOLN, RHODE ISLAND
TOWN OF LINCOLN




REVISIONS:

NO.	DATE	DESCRIPTION

PROJECT NO.: 08194.01
DATE: MARCH, 2012
SCALE: 1"=20'
DESIGNED BY: DMM
CHECKED BY: DMM
DRAWN BY: JHG
APPROVED BY: JMB

EXISTING SITE
PLAN

SHEET NO.: **2.0**

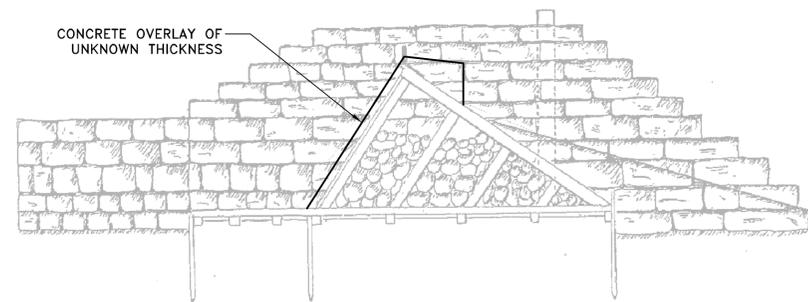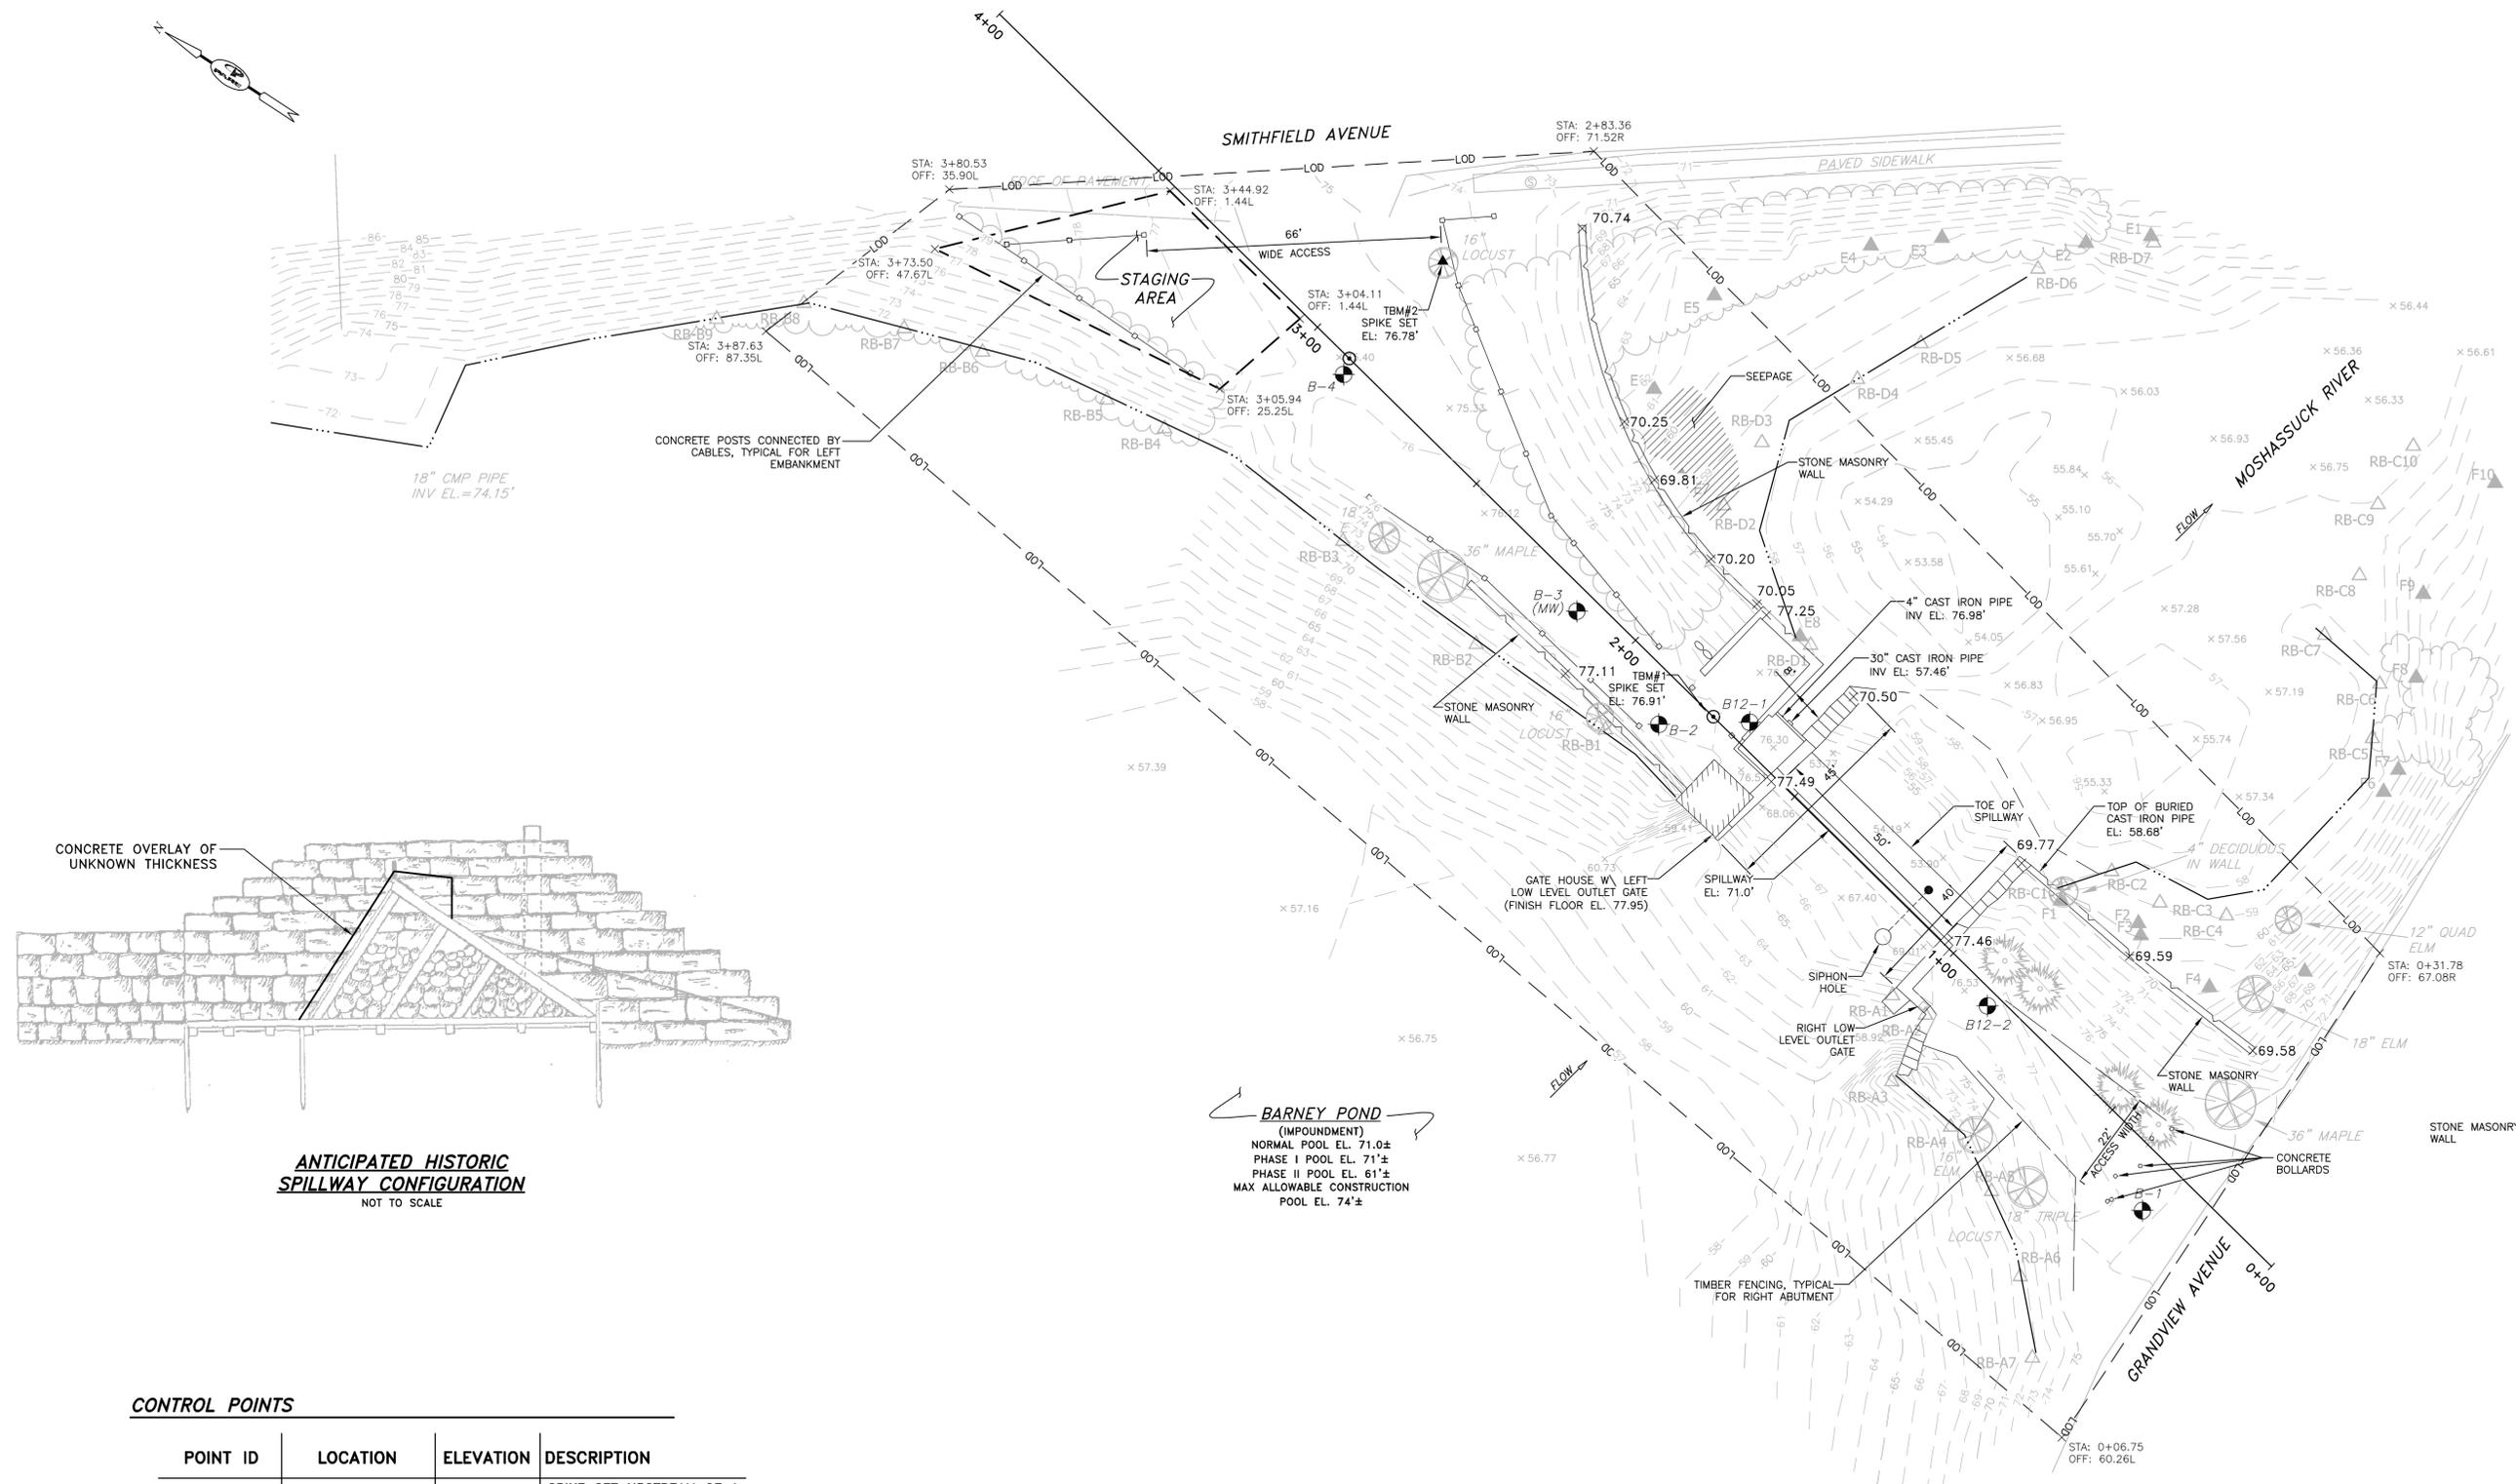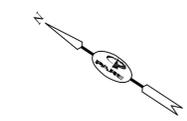

**ANTICIPATED HISTORIC
SPILLWAY CONFIGURATION**
NOT TO SCALE

BARNEY POND
(IMPOUNDMENT)
NORMAL POOL EL. 71.0±
PHASE I POOL EL. 71±
PHASE II POOL EL. 61±
MAX ALLOWABLE CONSTRUCTION
POOL EL. 74±

EXISTING SITE PLAN
SCALE: 1"=20'

CONTROL POINTS

POINT ID	LOCATION	ELEVATION	DESCRIPTION
⊙ TBM#1	STA: 1+76	76.91'	SPIKE SET UPSTREAM OF A CONCRETE PAD LOCATED TO THE LEFT (I.E. NORTHWEST) OF THE SPILLWAY
⊙ TBM#2	STATION 2+90	76.78'	SPIKE SET SHOWN ON PLAN

EXHIBIT D

AS-BUILT PLANS FOR DAM IMPROVEMENT PROJECT


Prepared for the:
TOWN OF LINCOLN
BARNEY POND DAM IMPROVEMENTS

RI DAM No: 101
 LINCOLN, RHODE ISLAND
 MARCH 2012

AS-BUILTS

Drawing Index

- 0.0 COVER SHEET
- 1.0 NOTES AND LEGEND
- 2.0 EXISTING SITE PLAN
- 2.1 EROSION CONTROL PLAN
- 3.0 DEMOLITION PLAN
- 4.0 PROPOSED SITE PLAN
- 5.0 PROPOSED SECTIONS
- 6.0 SPILLWAY PLAN AND SECTIONS
- 7.0 SPILLWAY DETAILS
- 8.0 TIMBER SPLIT RAIL FENCE LAYOUT PLAN AND DETAILS
- 9.0 LEFT LOW LEVEL OUTLET GATE EXISTING CONDITIONS
- 10.0 LEFT LOW LEVEL OUTLET GATE REHABILITATIONS
- 11.0 MISCELLANEOUS DETAILS

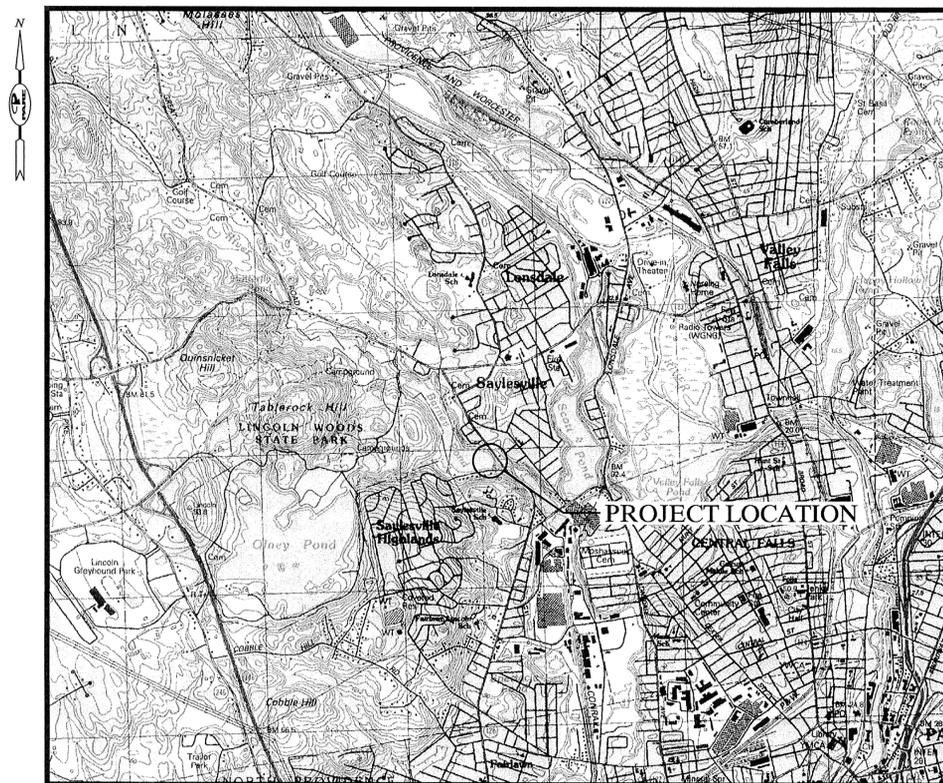

LOCUS PLAN
 SCALE: 1" = 2000'



AERIAL PLAN
 SCALE: 1" = 400'

Prepared by:
PARE CORPORATION
 Foxboro, Massachusetts



GENERAL NOTES:

- FOR THE PURPOSE OF THIS PROJECT:
OWNER – TOWN OF LINCOLN
100 OLD RIVER ROAD/P.O. BOX 100
LINCOLN, RI 02865
CONTACT: MR. LASZLO SIEGMUND, P.E. TOWN ENGINEER

ENGINEER – PARE CORPORATION
10 LINCOLN RD., SUITE 103
FOXBORO MA 02035
CONTACT: MR. J. MATTHEW BELLISLE, P.E.
- ALL CONSTRUCTION INDICATED ON THESE PLANS SHALL BE PERFORMED IN ACCORDANCE WITH THE LATEST EDITION OF THE RHODE ISLAND BUILDING CODE, THE SPECIFICATIONS INCLUDED IN THIS CONTRACT, AND RIDEM DAM SAFETY REGULATIONS.
- THESE PLANS ARE INCOMPLETE UNLESS ACCOMPANIED BY THE SPECIFICATIONS INCLUDED IN THE CONTRACT DOCUMENTS.
- TOPOGRAPHIC AND BATHYMETRIC SURVEY INFORMATION OBTAINED FROM A SURVEY PLAN, TITLED "EXISTING CONDITIONS IN THE TOWN OF LINCOLN, RI", DATED MARCH 8, 2007 BY HERITAGE DESIGN GROUP. CONTRACTOR SHALL NOTE THAT ADDITIONAL SCOURING AND/OR DEPOSITION MAY HAVE OCCURRED WITHIN THE WATER COURSES SINCE THE TIME OF THE SURVEY.
- INFORMATION REGARDING THE LOCATION OF SURROUNDING STRUCTURES, UTILITIES, AND THE AS-BUILT CONFIGURATION AND CONDITION OF THE EXISTING DAM AND SPILLWAY IS FURNISHED SOLELY FOR THE CONVENIENCE OF THE CONTRACTOR AND SHALL BE FIELD VERIFIED. THE CONTRACTOR SHALL CONDUCT ITS OWN INDEPENDENT EXAMINATION OF SITE CONDITIONS FOR THE PURPOSE OF BIDDING, FABRICATION, AND CONSTRUCTION ASSOCIATED WITH THE PROJECT. ANY RELIANCE UPON INFORMATION MADE AVAILABLE BY THE TOWN OF LINCOLN OR THE ENGINEER SHALL BE AT THE CONTRACTOR'S RISK.
- DEPTHS AND THICKNESS OF THE SUBSURFACE STRATA INDICATED HEREIN ARE GENERALIZED FROM THE SUBSURFACE DATA COLLECTED BY PARE. INFORMATION SHOWN FOR THE DAM IS INTERPOLATED AND MAY DIFFER DUE TO THE VARYING NATURE OF GLACIAL DEPOSITS AND MANMADE FILL.
- CONTRACTOR SHALL BE RESPONSIBLE FOR VERIFYING ALL DIMENSIONS. PLANS SHALL NOT BE SCALED FOR DIMENSIONS.
- THE DATUM FOR THE PROJECT IS THE NAUTICAL GEODETIC VERTICAL DATUM OF 1929 (NGVD 29). THE BENCHMARK ELEVATION OF 76.78 IS LOCATED ON A SPIKE SET UPSTREAM OF A CONCRETE PAD LOCATED TO THE LEFT (I.E. NORTHWEST) OF THE SPILLWAY. CONTRACTOR SHALL ESTABLISH HORIZONTAL AND VERTICAL CONTROL AS REQUIRED TO ENABLE COMPLETION OF WORK THROUGHOUT THE DURATION OF THE PROJECT.
- CONSTRUCTION SHALL BE MADE FROM APPROVED SHOP DRAWINGS ONLY.
- NOTES, TYPICAL DETAILS, AND SCHEDULES APPLY TO ALL WORK UNLESS OTHERWISE NOTED. FOR CONDITIONS NOT SPECIFICALLY SHOWN, PROVIDE DETAILS OF SIMILAR NATURE. VERIFY APPLICABILITY BY SUBMITTING SHOP DRAWINGS FOR REVIEW.
- WHERE REFERENCE IS MADE TO ANY SPECIFICATION, CODE, STANDARD, OR INTERIM SPECIFICATIONS OF THE ORGANIZATION REFERRED TO AND SHALL BE CONSIDERED A PART OF THESE CONTRACT DOCUMENTS TO THE EXTENT INDICATED. IN CASE OF CONFLICT, THE MORE RIGID REQUIREMENTS AND CODES SHALL GOVERN.
- CONTRACTOR WILL BE REQUIRED TO SUBMIT A CONSTRUCTION SCHEDULE TO THE OWNER WITHIN 3 DAYS OF THE NOTICE OF AWARD. THE CONTRACTOR SHALL UPDATE THE SCHEDULE AS NEEDED THROUGHOUT THE COURSE OF WORK.
- CONTRACTOR SHALL STAGE ALL EQUIPMENT IN THE DESIGNATED STAGING AREA. ALL GREASING AND REFUELING ACTIVITIES SHALL OCCUR IN THE STAGING AREA(S).
- CONTRACTOR SHALL PROVIDE A MINIMUM OF 24 HOURS NOTICE PRIOR TO INCREASING FLOW IN THE DOWNSTREAM AREA DUE TO ADJUSTMENT OF POSSIBLE OUTLETS.
- UPON COMPLETION OF THE PROJECT, CONTRACTOR IS TO PROVIDE TWO AS-BUILT PLAN SETS TO THE OWNER DEPICTING ANY FIELD CHANGES OF DIMENSIONING OR DETAIL, LOCATION OF UNDERGROUND STRUCTURES AND/OR UTILITIES, CONSTRUCTION DEVIATIONS, CHANGES DUE TO FIELD OR CHANGE ORDER, AND DETAILS NOT ON THE ORIGINAL DRAWINGS.
- CONTRACTOR WILL BE REQUIRED TO ATTEND WEEKLY PROGRESS MEETINGS AS REQUESTED BY THE OWNER.
- THE CONTRACTOR SHALL BE RESPONSIBLE FOR DISPOSAL OF ALL PROJECT DEMOLITION AND EXCESS MATERIAL IN ACCORDANCE WITH RHODE ISLAND, LOCAL, AND FEDERAL LAWS.
- CONTRACTOR SHALL BE RESPONSIBLE FOR ALL DAMAGE TO ADJACENT STRUCTURES AND UTILITIES AT NO ADDITIONAL COST TO THE OWNER.
- THE CONTRACTOR SHALL FOLLOW ALL OSHA AND OTHER APPLICABLE FEDERAL, STATE AND LOCAL STANDARDS FOR ALL PROJECT COMPONENTS AND ACTIVITIES.
- ALL CONSTRUCTION ACTIVITIES SHALL BE CONFINED TO THE LIMITS OF WORK AND TEMPORARY EASEMENTS DEFINED HEREIN.
- IMPOUNDMENT BATHYMETRIC CONTOURS SHALL NOT BE CONSIDERED THE TOP OF A FIRM IMPOUNDMENT BOTTOM. THE CONTRACTOR SHALL FIELD VERIFY THIS IN PROPOSED COFFERDAM AREAS THROUGH PROBING, IF DEEMED NECESSARY, FOR THE CONTRACTOR'S COFFERDAM SUBMITTAL AT NO EXTRA COST TO THE OWNER.
- CONTRACTOR SHALL MAINTAIN A SECURE SITE AND PROVIDE APPROPRIATE SAFETY MEASURES TO PREVENT ACCIDENTS. THE SAFETY MEASURES SHALL INCLUDE, BUT NOT BE LIMITED TO SIGNAGE, BARRICADES, FENCES, FLASHING WARNING LIGHTS, AND POLICING IF NECESSARY.
- THE CONTRACTOR WILL BE RESPONSIBLE FOR RETURNING ALL PORTIONS OF DISTURBED AREAS, AND ANY OTHER PROPERTY TO PRE CONSTRUCTION CONDITIONS.
- ANY UTILITIES, INCLUDING, BUT NOT LIMITED TO, WATER, GAS, AND OVERHEAD WIRES THAT MAY BE LOCATED WITHIN THE SITE SHALL BE PROTECTED DURING CONSTRUCTION. THE CONTRACTOR SHALL CONTACT DIG SAFE PRIOR TO UNDERTAKING ANY EXCAVATION.
- CONTRACTOR SHALL SUPPORT AND PROTECT ALL UTILITIES WITHIN THE LIMITS OF WORK.

ANTICIPATED CONSTRUCTION SEQUENCE:

THE FOLLOWING SEQUENCE IS INTENDED TO BE GENERAL IN NATURE AND SHALL NOT BE CONSIDERED DIRECTION BY THE ENGINEER OR THE OWNER. ALTHOUGH IT IS LIKELY THAT SOME OF THE WORK ITEMS WILL OVERLAP, CONSTRUCTION SEQUENCES FOR THE VARIOUS PROJECT COMPONENTS ARE DESCRIBED SEPARATELY AND MAY NOT NECESSARILY PROCEED IN CONSECUTIVE ORDER. ALL WORK SHALL BE PERFORMED IN ACCORDANCE WITH THE PROJECT PLANS AND SPECIFICATIONS.

GENERAL

- CONTRACTOR MOBILIZATION
- INSTALL SIGNAGE
- INSTALL PERIMETER EROSION CONTROLS (PHASE 1 AND PHASE 2) INCLUDING TURBIDITY BARRIER.
- REMOVE AND STOCKPILE EXISTING SITE FEATURES AS NECESSARY TO FACILITATE SITE ACCESS.
- INSTALL/CONSTRUCT TEMPORARY SITE ACCESS WAYS (PHASE 1 AND PHASE 2).
- INSTALL WATER DIVERSION AND WATER CONTROL DEVICES AS NECESSARY AND REQUIRED (SEE DIVERSION OF WATER NOTES).

LOW LEVEL OUTLET

- REHABILITATE THE LEFT LOW LEVEL OUTLET STRUCTURE IN ACCORDANCE WITH THE CONTRACT DOCUMENTS, INCLUDING THE REMOVAL AND REPLACEMENT OF THE CONTROL HOUSE'S ROOF.
- REMOPTAR THE STONE MASONRY WALL BETWEEN THE SPILLWAY AND LEFT OUTLET DISCHARGE CHANNEL.

TREE AND STUMP REMOVAL

- CUT AND REMOVE ALL TREES, SHRUBS, AND BRUSH FROM THE UPSTREAM SLOPE, THE CREST AND BEYOND THE DOWNSTREAM WALLS WITHIN THE LIMITS OF WORK AS INDICATED.
- REMOVE ALL STUMPS AND OTHER UNDESIRABLE MATERIAL FROM EMBANKMENTS.
- REMOVE AND BACKFILL ROOT SYSTEMS AND BACKFILL EMBANKMENT WITH SELECT COMPACTED MATERIAL.
- EXCAVATE EMBANKMENT SOILS TO LIMITS INDICATED.
- FILL RESULTING HOLES WITH SELECT COMPACTED MATERIAL.

SPILLWAY AND LOW LEVEL OUTLET STRUCTURES AND ASSOCIATED WALLS

- ABANDON THE RIGHT LOW LEVEL OUTLET STRUCTURE IN ACCORDANCE WITH THE CONTRACT DOCUMENTS.
- FILL SIPHON HOLE AT UPSTREAM EDGE OF EXISTING SPILLWAY.
- DEMOLISH AND DISPOSE OF EXISTING SPLASH PAD AND TOE OF EXISTING SPILLWAY AS INDICATED ON THE PLANS.
- INSTALL NEW SHEET PILE CUTOFF WALL AND PERFORM PERMEATION GROUTING IN FRONT OF AND BELOW THE SPILLWAY TRAINING WALLS.
- CONSTRUCT NEW REINFORCED CONCRETE SPILLWAY.
- INSTALL, TENSION, AND TEST TIE DOWN ANCHORS AS INDICATED IN THE CONTRACT DOCUMENTS.
- INSTALL SCOUR PAD.
- INSTALL UPSTREAM AND DOWNSTREAM CHANNEL RIPRAP.

SEEPAGE MITIGATION

- INSTALL SHEET PILE CUTOFF WALL THROUGH THE LEFT EARTHEN EMBANKMENT AS INDICATED ON THE CONTRACT DOCUMENTS.
- PERFORM ISOLATED PERMEATION GROUTING IN THE AREA OF THE LEFT LOW LEVEL OUTLET PIPE AND TOWARDS THE BACKSIDE OF THE LEFT SPILLWAY TRAINING WALL.

DOWNSTREAM WALL REPAIRS

- REPAIR AND REPOINT THE UPPER PORTION OF THE DOWNSTREAM WALL IN THE AREA TO THE LEFT OF THE CHANNEL FOR THE LOW LEVEL OUTLET (LOCATED LEFT OF THE SPILLWAY).

SLOPE AND GRADING STABILIZATION

- PLACE, GRADE, AND COMPACT SUITABLE FILL MATERIAL TO THE LINES AND GRADES SHOWN ON THE PROJECT PLANS.
- IN AREAS TO BE STABILIZED WITH RIPRAP INSTALL TOE STONES (WHERE INDICATED), GEOTEXTILE FABRIC, BEDDING STONE, AND RIPRAP ARMOR STONE
- IN AREAS TO BE STABILIZED WITH VEGETATION, PLACE AND GRADE LOAM AND SEED.

DRAINAGE SYSTEM

- UPGRADE DRAINAGE SWALES AS INDICATED ON PLANS.

STABILIZE THE DOWNSTREAM WALLS

- INSTALL STONE RIPRAP BUTTRESS ALONG THE TOE OF THE DOWNSTREAM WALLS AS INDICATED ON THE PLANS. (ADD ALT. 1)

SAFETY RAILINGS

- INSTALL TIMBER SPLIT RAIL FENCING BEHIND THE TOP OF THE TRAINING WALLS AND DOWNSTREAM WALLS AS INDICATED ON THE PLANS.

PROJECT COMPLETION

- PLACEMENT OF LOAM AND SEED ON THE UPSTREAM SLOPE, DOWNSTREAM SLOPE, AND ALL AREAS DISTURBED BY THE CONSTRUCTION ACTIVITIES.
- PLACEMENT OF ROADWAY MATERIAL AND SHOULDER FILL ON DAM CREST.
- LOAM AND SEED DAM CREST.
- NOTIFY ENGINEER / OWNER OF SUBSTANTIAL PROJECT COMPLETION.
- DEMOLIBLIZE AND RETURN DISTURBED AREAS OF THE SITE TO PRECONSTRUCTION CONDITIONS.

CONCRETE NOTES:

- CONCRETE WORK SHALL BE IN ACCORDANCE WITH ACI 318-08 BUILDING CODE REQUIREMENTS FOR REINFORCED CONCRETE OR LATEST EDITION.
- UNLESS NOTED OTHERWISE CONCRETE SHALL BE NORMAL WEIGHT WITH TYPE II CEMENT AND AS FOLLOWS:
4,000 PSI AT 28 DAYS 1 1/2" AGGREGATE – TYPICAL
2,500 PSI AT 56 DAYS 1 1/2" AGGREGATE – MASS CONCRETE
- CONCRETE SHALL BE AIR-ENTRAINED. PERCENTAGE OF ENTRAINED AIR SHALL BE 6%±1%.
- THE MAXIMUM WATER CEMENT RATIO SHALL BE AS FOLLOWS:
– 0.45 MAX – TYPICAL CONCRETE (4,000 PSI)
– 0.48 MAX – MASS CONCRETE (2,500 PSI)
- THE TRICALCIUM ALUMINATE (C3A) SHALL BE LESS THAN 4%.
- CALCIUM CHLORIDE SHALL NOT BE USED.
- ALL CONCRETE SHALL BE PLACED IN THE DRY.
- THE CONCRETE SLUMP SHALL NOT EXCEED 3 INCHES.
- REINFORCING STEEL SHALL CONFORM TO ASTM A-615 OR A-706 (WELDABLE) GRADE 60.
- COMPLETE SHOP DRAWINGS AND SCHEDULES OF ALL REINFORCING STEEL SHALL BE PREPARED BY THE CONTRACTOR AND SUBMITTED TO THE ENGINEER FOR APPROVAL PRIOR TO COMMENCEMENT OF THAT PORTION OF THE WORK. ALL ACCESSORIES MUST BE SHOWN ON THE SHOP DRAWINGS.
- ALL REINFORCING STEEL SHALL BE EPOXY COATED. ALL SUPPORTS SUCH AS CHAIRS, BOLSTERS, SPACERS, BLOCKS AND HANGERS SHALL BE OF NON-CORROSIVE MATERIAL.
- DETAILING OF CONCRETE REINFORCING AND ACCESSORIES SHALL BE IN ACCORDANCE WITH THE LATEST EDITION OF ACI PUBLICATION 315.
- WHEN REINFORCEMENT IS LAP SPLICED CLASS B SPLICES SHALL BE PROVIDED IN ACCORDANCE WITH ACI-318.
- UNLESS OTHERWISE NOTED, MINIMUM CONCRETE COVER FOR THE SPILLWAY AND SCOUR PAD REINFORCING STEEL SHALL BE AS SPECIFIED IN ACI 318-08 SECTION 7.7 CORROSIVE ENVIRONMENTS.
- THE EXPOSED SURFACE OF THE SPILLWAY SHALL BE RUBBED AND ALL VOIDS, AIR POCKETS, DEFORMATIONS FILLED WITH EPOXY FILLER.
- THE TOP SURFACE OF THE SCOUR PAD SHALL BE HAND FLOATED TO A SMOOTH FINISH.
- PROVIDE A 3/4" CHAMFER ON ALL EXPOSED EDGES OF CONCRETE.
- CONCRETE SHALL BE SAW CUT NO MORE THAN 12 HOURS AFTER PLACEMENT OF THE CONCRETE.

TREE REMOVAL NOTES:

- CONTRACTOR SHALL CUT, REMOVE, GRUB ROOTS, AND DISPOSE ALL TREES AND STUMPS FROM WITHIN THE LIMITS OF WORK.
- ALL DISPOSAL SHALL BE PERFORMED IN ACCORDANCE WITH LOCAL, STATE, AND FEDERAL REQUIREMENTS.


MISCELLANEOUS STEEL NOTES:

- CUTOFF WALL SHEETING SHALL BE AZ 14-770 (OR EQUAL) CONTINUOUSLY INTERLOCKING TYPE AND SHALL CONFORM TO ASTM A572 – GRADE 50 WITH A MINIMUM SECTION MODULUS OF 25.2 CUBIC INCHES PER LINEAR FOOT AND A MINIMUM NOMINAL WEB THICKNESS OF 0.375 INCHES. THE CUTOFF SHEETING SHALL BE NEW AND HOT ROLLED TO MINIMIZE INTERLOCK LEAKAGE. LIFTING HOLES OR OTHER PENETRATIONS IN THE CUTOFF SHEETING SHALL BE SEALED AS DIRECTED BY THE ENGINEER.

LOAM AND SEED NOTES:

- CONTRACTOR SHALL APPLY FERTILIZER AND LOAM TO PREPARED TOPSOIL SURFACE AT THE RATES INDICATED IN THE PROJECT SPECIFICATIONS.
- CONTRACTOR SHALL SEED ENTIRE DAM AND DISTURBED AREA AS INDICATED IN THE PROJECT SPECIFICATIONS.
- CONTRACTOR SHALL MULCH ENTIRE SEEDED AREA WITH STRAW MULCH.
- CONTRACTOR SHALL INSTALL JUTE MESH OVER ENTIRE SEEDED AREA IN ACCORDANCE WITH MANUFACTURER'S RECOMMENDATIONS FOR OVERLAPPING, ANCHORING, AND DIRECTION OF PLACEMENT.
- CONTRACTOR SHALL ESTABLISH AND MAINTAIN A HEALTHY STAND OF GRASS AS INDICATED IN THE SPECIFICATIONS
- RETAINAGE WILL BE HELD TILL AN ACCEPTABLE STAND OF GRASS, AS INDICATED IN THE PROJECT SPECIFICATIONS, HAS BEEN ESTABLISHED.

LEGEND

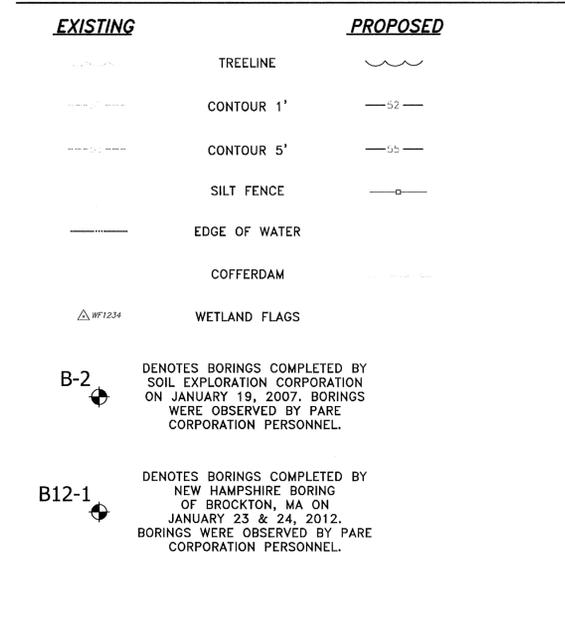


ABBREVIATIONS



DIVERSION OF WATER NOTES:

- THE CONTRACTOR SHALL MAINTAIN FLOW THROUGHOUT CONSTRUCTION.
- CONTRACTOR SHALL BE RESPONSIBLE FOR PREVENTING ANY SOIL OR OTHER MATERIAL FROM ENTERING THE RIVER CHANNEL OR IMPOUNDMENT.
- CONTRACTOR SHALL BE RESPONSIBLE FOR ALL LOSS AND DAMAGE DUE TO A FAILURE OF ANY DIVERSION STRUCTURES CONSTRUCTED DURING THE WORK.
- CONTRACTOR SHALL REGULATE DISCHARGES AND PHASE CONSTRUCTION SO THAT CONSTRUCTION EQUIPMENT DOES NOT PASS THROUGH FLOWING WATER.
- IN ACCORDANCE TO RIDEM RULE 10, THE DAM IS REQUIRED TO BE CAPABLE OF PAVING FLOWS ASSOCIATED WITH A 10-YEAR STORM (I.E., FOR CONSTRUCTION PROJECTS BETWEEN 3 AND 6 MONTHS IN LENGTH). TO ACCOMMODATE THE ESTIMATED VOLUME OF WATER ASSOCIATED WITH THE FLOWS FROM THE 10-YEAR STORM, THE CONTRACTOR SHALL PERFORM THE FOLLOWING
 - AFTER THE REHABILITATION OF THE LEFT LOW LEVEL OUTLET IS COMPLETED AND BEFORE COMMENCING THE DEMOLITION OF THE SCOUR PAD, THE CONTRACTOR SHALL DRAW DOWN THE IMPOUNDMENT TO EL. 61.0 USING THE REHABILITATED OUTLET.
 - AFTER THE IMPOUNDMENT IS DRAWN DOWN, THE CONTRACTOR SHALL INSTALL A COFFERDAM UPSTREAM OF THE EXISTING SPILLWAY THAT WOULD ALLOW THE POND TO FILL FROM THE ABOVE MENTIONED DRAW DOWN LEVEL TO A MAXIMUM ELEVATION OF 74.0 AS A RESULT OF STORM FLOW
 - IN ADDITION TO THE COFFERDAM, THE CONTRACTOR SHALL DESIGN, INSTALL, AND MAINTAIN A BYPASS SYSTEM CAPABLE OF PASSING A MINIMUM FLOW OF 200 CUBIC FEET PER SECOND, INCLUDING FLOWS FROM THE REHABILITATED LEFT LOW LEVEL OUTLET. THE EXISTING RIGHT LOW LEVEL OUTLET (IN ITS CURRENT CONDITION) SHALL NOT BE USED FOR BYPASS PURPOSES.
- ANY NECESSARY DIVERSIONS AND COFFERDAMS SHALL BE DESIGNED BY THE CONTRACTOR AND SHALL BE APPROVED BY THE OWNER AND ENGINEER PRIOR TO INSTALLATION. ALL DIVERSIONS SHALL BE INSTALLED AND REMOVED IN THEIR ENTIRETY AT NO ADDITIONAL COST TO THE OWNER.

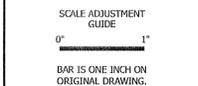

BARNEY POND DAM IMPROVEMENTS
 RIDEM ID: 0101
 LINCOLN, RHODE ISLAND
 TOWN OF LINCOLN

REVISIONS:	

PROJECT NO.:	08194.01
DATE:	MARCH, 2012
SCALE:	AS NOTED
DESIGNED BY:	DMM
CHECKED BY:	DMM
DRAWN BY:	JHG / GLB
APPROVED BY:	JMB

NOTES AND LEGEND

SHEET NO.: 1.0

P:\2005\08 Jobs\08194.01 Barney Pond\Drawings\1.0 - Notes and Legend.dwg

MAS Building & Bridge, Inc.
Barney Pond Dam Improvements
Lincoln, RI

R.F.I. # Barney-509
DATE: 8/10/12

R.F.I. FORM

Engineer:
Pare Corporation
10 Lincoln Road, Suite 103
Frobosc, MA 02035

General Contractor:
MAS Building & Bridge, Inc.
P.O. 49
Franklin, MA 02038
Phone: 508-520-2277
Fax: 508-520-2276

This is a Request For Information/Clarification/Interpretation related to the Contract Documents/Specifications.

QUESTION:


Please refer to section C on drawing 8.0. The 4 corners of the scour pad were set up for control. From there the actual dimension from the scour pad to the existing spillway is 15'-6". At the base there is vertical timber lagging. On drawing 3.0 a note states to "R&D look at existing spillway as needed." MAS is concerned that demolishing part of the spillway and having to remove the vertical lagging, will compromise the existing structure. MAS proposes to leave the structure as is and decrease the 17'-6" dimension from the scour pad to the spillway to 15'-6". Please confirm this is acceptable.

Originated By: Fred Sorbo Information Required Not Later Than: 8/15/2012

REPLY: Date Received: 8/10/12

[ARE has run through stability analyses of the new spillway considering leaving the existing spillway in place and abutting up the upstream side of the proposed spillway base and has determined that the new spillway section satisfies stability requirements. This also takes into consideration the relocating of the cutoff floating per RFI No. 5. Therefore, the existing we can remain in place with the decrease in spillway base dimension as requested.

Response By: David Matheson Date: 8/23/12

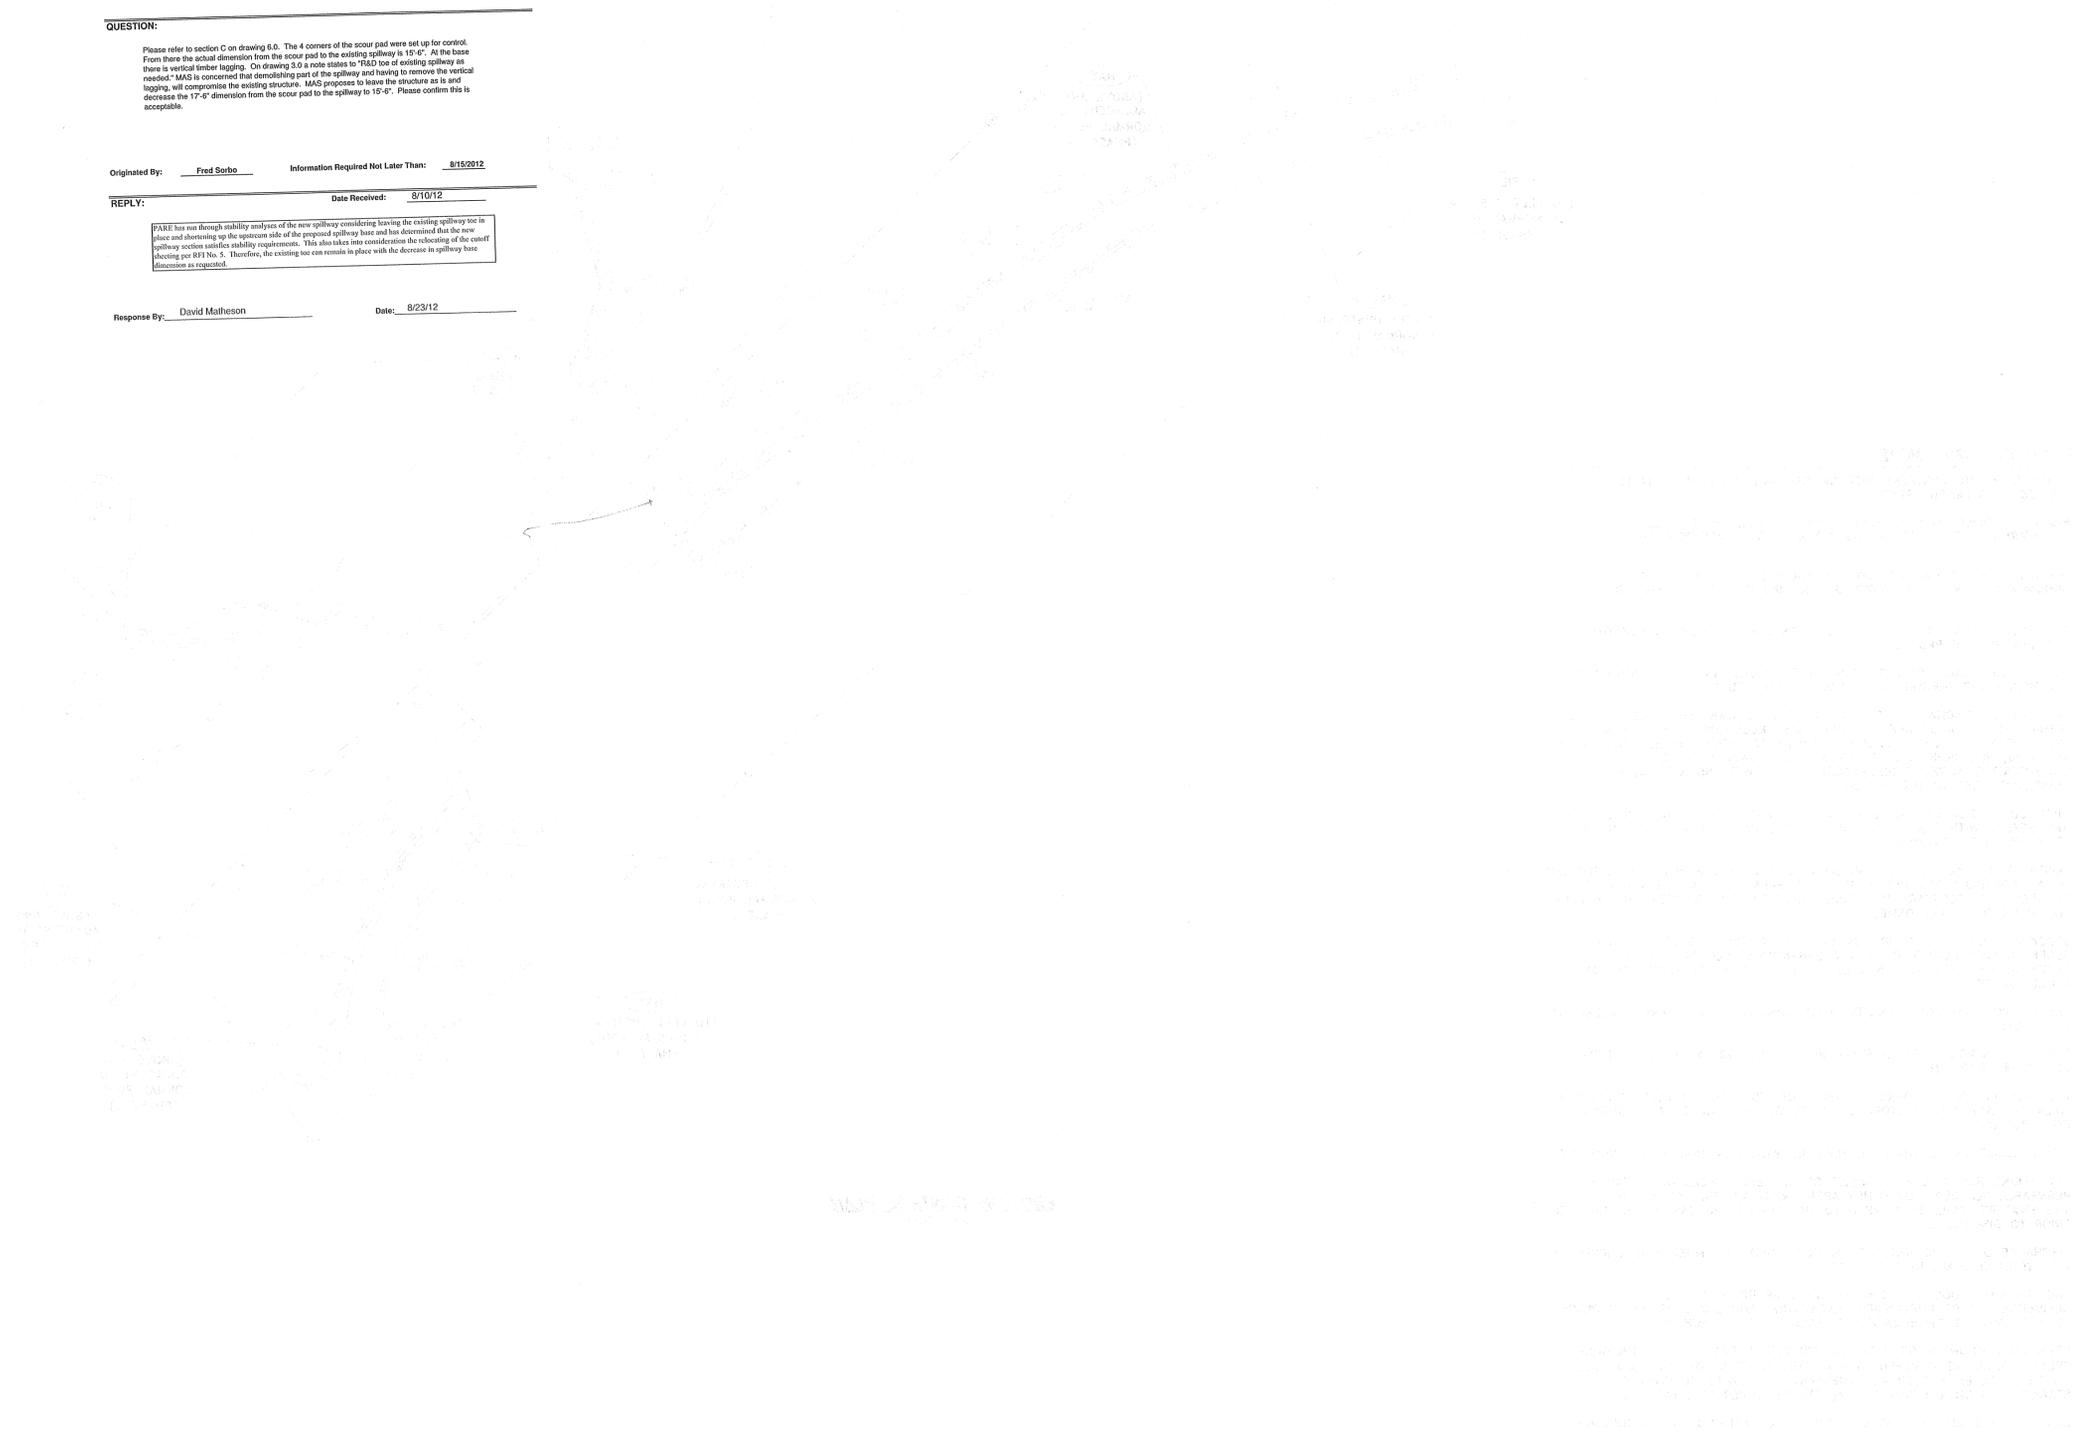



PARE CORPORATION
ENGINEERS - SCIENTISTS - PLANNERS
10 LINCOLN ROAD, SUITE 103
FOXBORO, MA 02035
508-943-1755

SCALE ADJUSTMENT
GUIDE
0' 1"
BAR IS ONE INCH ON
ORIGINAL DRAWING.

BARNEY POND DAM IMPROVEMENTS

RIDEM ID: 0101
LINCOLN, RHODE ISLAND
TOWN OF LINCOLN


REVISIONS:

NO.	DATE	DESCRIPTION

PROJECT NO.: 08194.01
DATE: MARCH, 2012
SCALE: 1"=20'
DESIGNED BY: DMM
CHECKED BY: DMM
DRAWN BY: AWB
APPROVED BY: JMB

DEMOLITION PLAN

SHEET NO.: 3.0

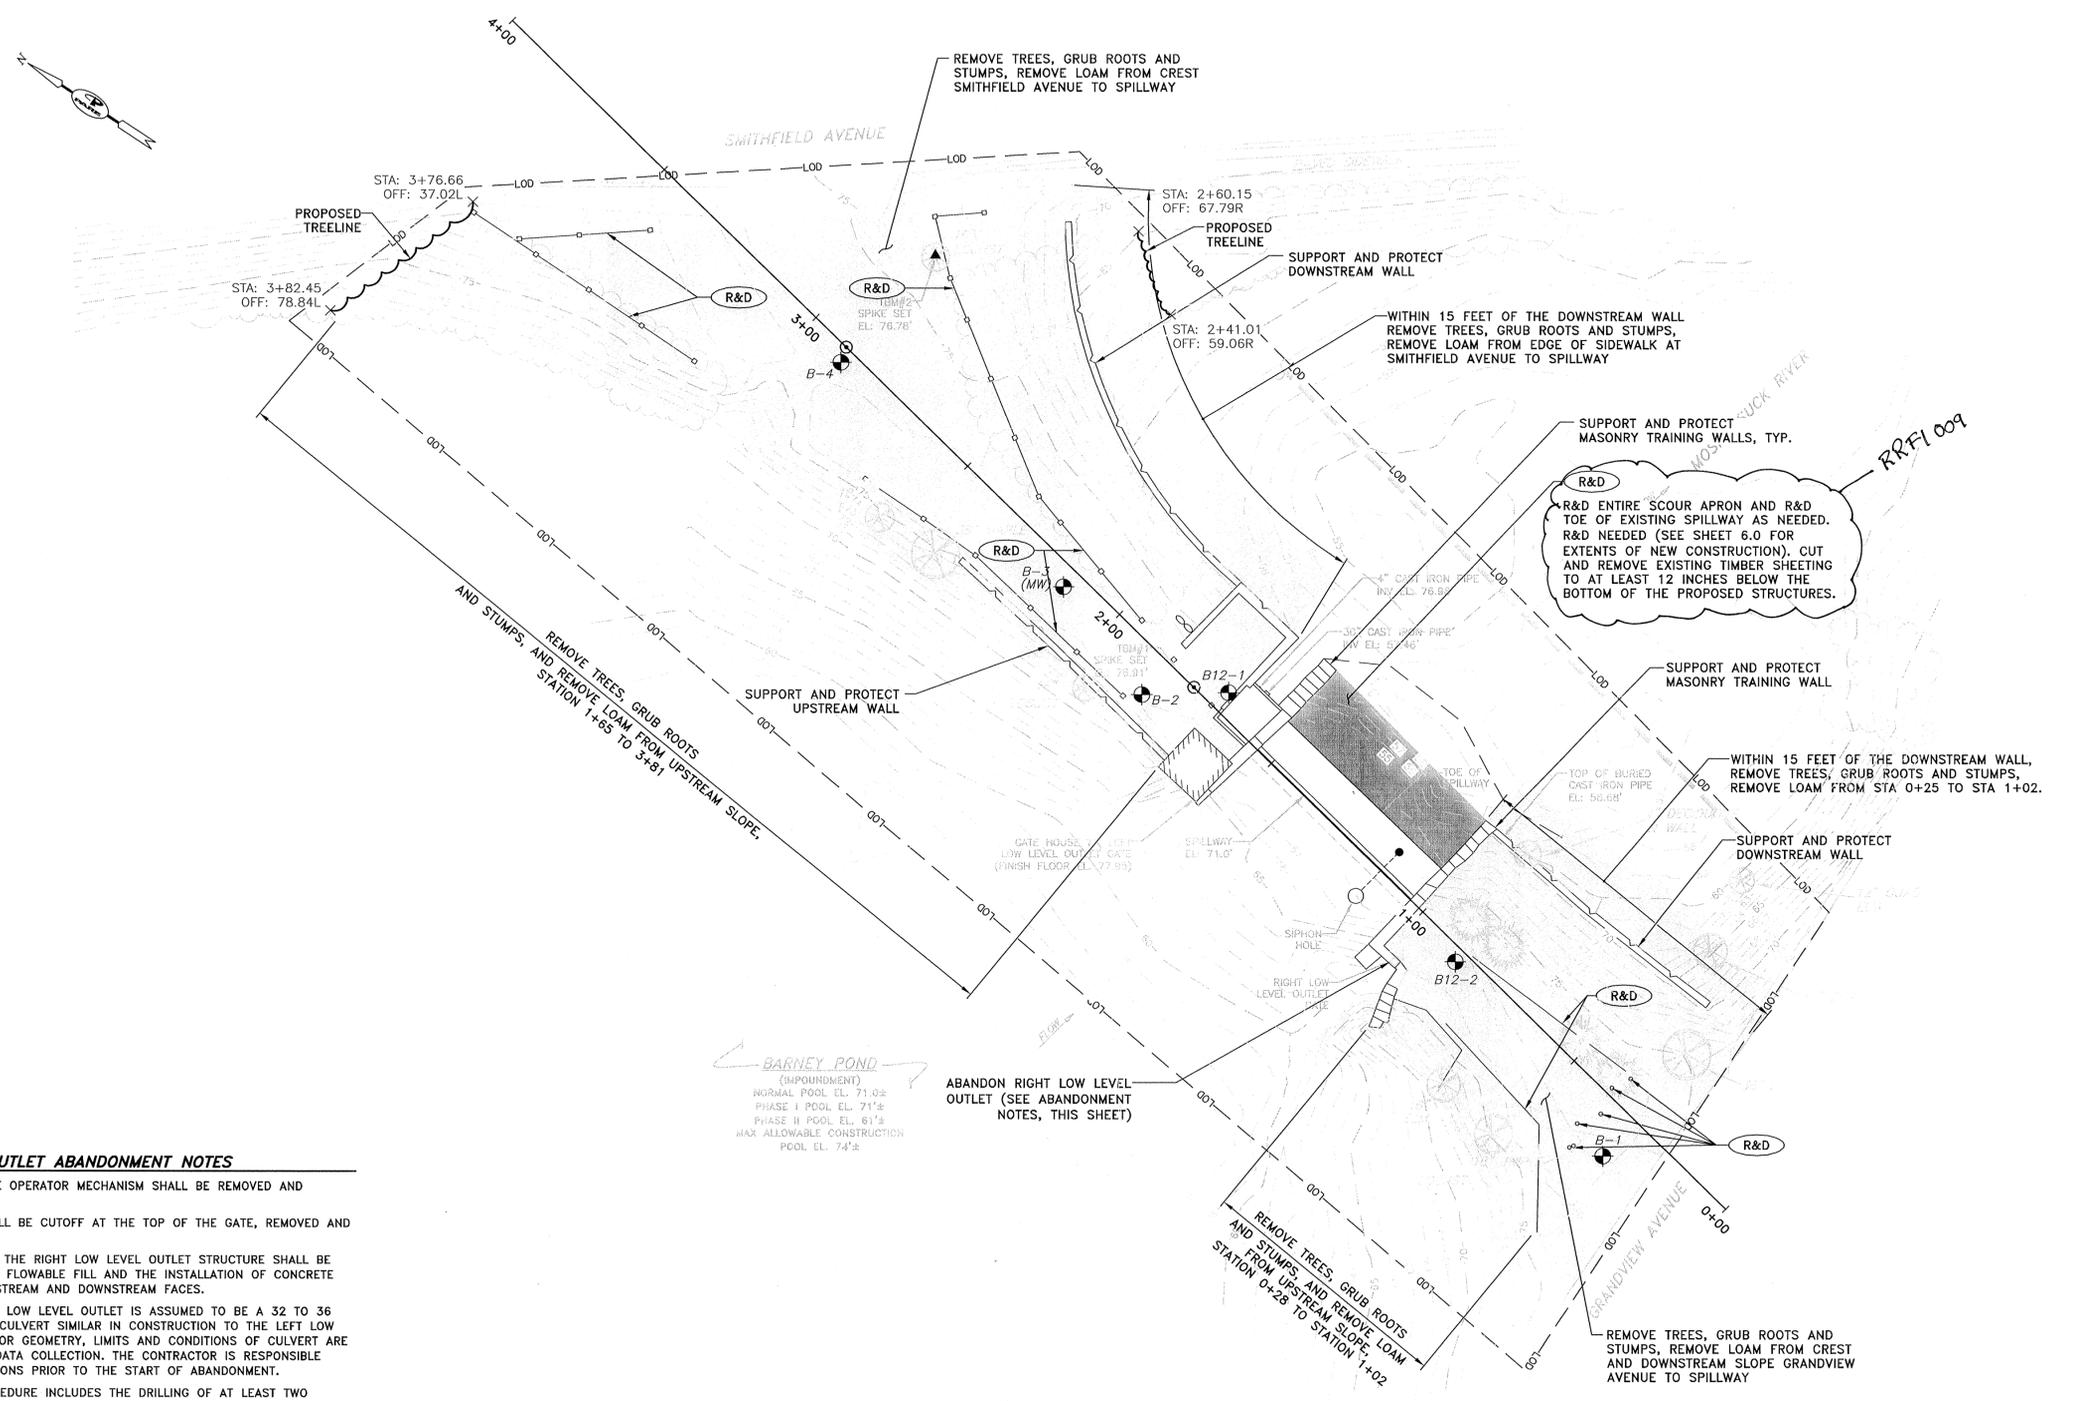

SITE SKETCH
SCALE: 1"=20'

RIGHT LOW LEVEL OUTLET ABANDONMENT NOTES

1. THE REMNANTS OF THE OPERATOR MECHANISM SHALL BE REMOVED AND DISPOSED.
2. THE TIMBER STEM SHALL BE CUTOFF AT THE TOP OF THE GATE, REMOVED AND DISPOSED.
3. THE ABANDONMENT OF THE RIGHT LOW LEVEL OUTLET STRUCTURE SHALL BE THROUGH FILLING WITH FLOWABLE FILL AND THE INSTALLATION OF CONCRETE PLUGS ALONG THE UPSTREAM AND DOWNSTREAM FACES.
4. THE CULVERT FOR THE LOW LEVEL OUTLET IS ASSUMED TO BE A 32 TO 36 INCH DIAMETER STEEL CULVERT SIMILAR IN CONSTRUCTION TO THE LEFT LOW LEVEL OUTLET. INTERIOR GEOMETRY, LIMITS AND CONDITIONS OF CULVERT ARE BASED UPON LIMITED DATA COLLECTION. THE CONTRACTOR IS RESPONSIBLE FOR VERIFYING CONDITIONS PRIOR TO THE START OF ABANDONMENT.
5. THE ANTICIPATED PROCEDURE INCLUDES THE DRILLING OF AT LEAST TWO VENT/FILL HOLES THROUGH THE CREST OF THE DAM IN ADDITION TO THE USE OF TREMIE PLACEMENT TECHNIQUES TO FACILITATE A FULL ABANDONMENT. THE VENT HOLES SHALL BE HELD OPEN WITH CASING AND ABANDONNED WITH A NONSHRINK GROUT OR FLOWABLE FILL AT THE COMPLETION OF THE ABANDONMENT.
6. THE CULVERT ABANDONMENT SHALL BE PERFORMED WITH NO HORIZONTAL COLD JOINTS PERMITTED.
7. THE CULVERT IS TO BE FILLED WITH A NON EXCAVATABLE, NONSHINK, LOW PERMEABILITY FLOWABLE FILL.
8. THE CONTRACTOR SHALL SUBMIT AN ABANDONMENT PROCEDURE AND DESIGN PRIOR TO UNDERTAKING THE WORK.
9. THE FORMWORK AT THE DOWNSTREAM END OF CULVERT SHALL HAVE SUFFICIENT STRENGTH TO RESIST PRESURES ASSOCIATED WITH UNCURRENT FLOWABLE FILL.
10. THE EXISTING GATE ON THE UPSTREAM END OF THE OUTLET SHALL BE LEFT IN PLACE, SEALED, AND SUFFICIENTLY REINFORCED TO RESIST PRESURES ASSOCIATED WITH UNCURRENT FLOWABLE FILL.



PARE CORPORATION
 ENGINEERS - SCIENTISTS - PLANNERS
 10 LINCOLN ROAD, SUITE 103
 FOXBORO, MA 02035
 508-543-1755

SCALE ADJUSTMENT
 GUIDE
 0" 1"
 BAR IS ONE INCH ON
 ORIGINAL DRAWING.

BARNEY POND DAM IMPROVEMENTS

RJ DEM ID: 0101
 LINCOLN, RHODE ISLAND
 TOWN OF LINCOLN


REVISIONS:

PROJECT NO.: 08194.01
 DATE: MARCH, 2012
 SCALE: AS NOTED
 DESIGNED BY: DMM
 CHECKED BY: DMM
 DRAWN BY: AWB
 APPROVED BY: JMB


PROPOSED
 SECTIONS

SHEET NO.:

5.0

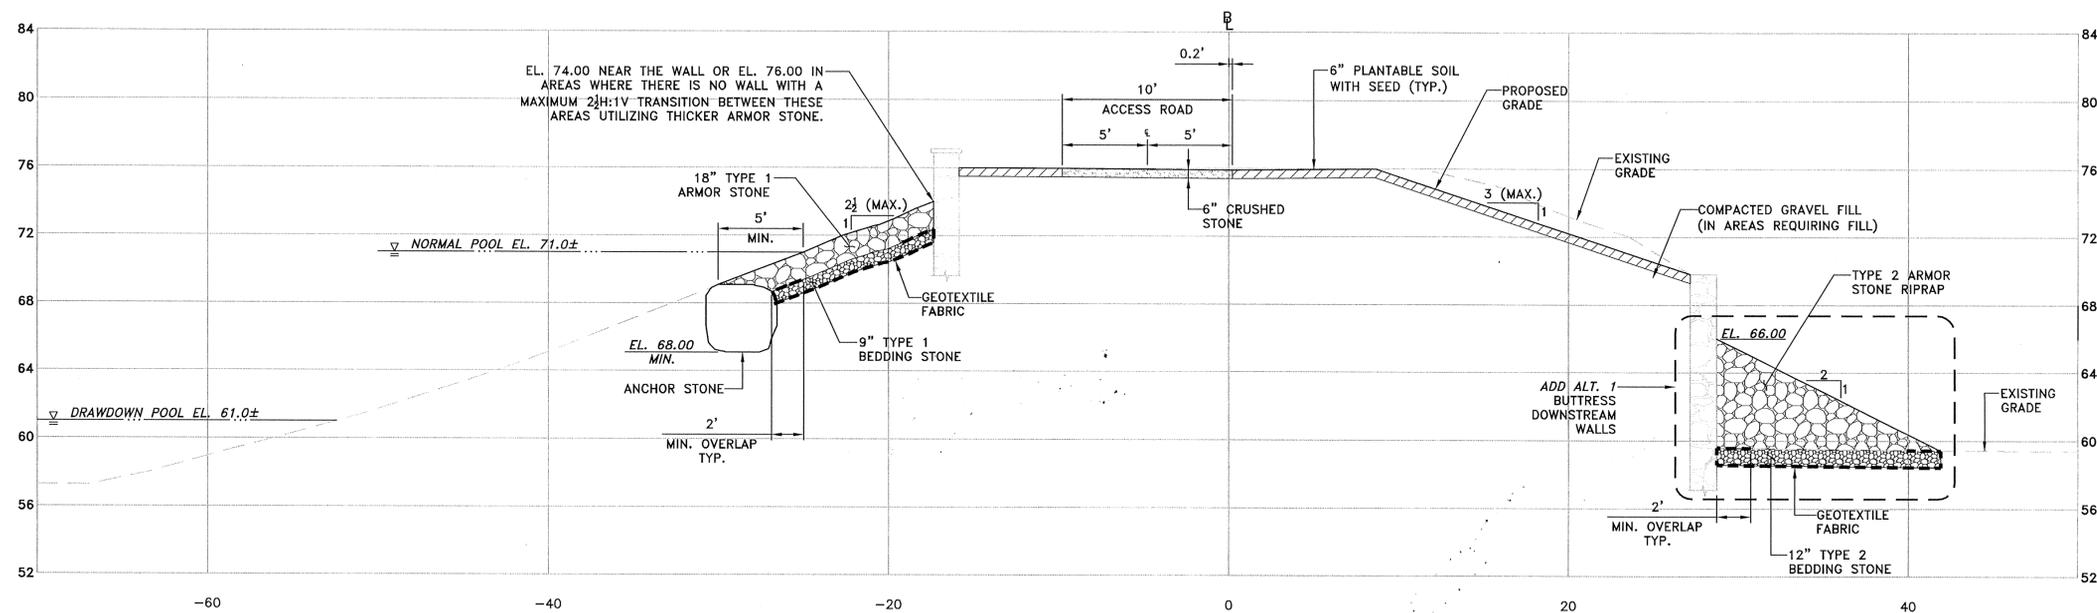

- NOTES**
1. STRIP TOPSOIL PRIOR TO PLACEMENT OF BUTTRESS.
 2. BUTTRESS RIPRAP SHALL BE PLACED IN A TIGHT MATRIX.
 3. SHOULD BUTTRESS NOT BE INSTALLED, CONTRACTOR SHALL INSTALL MINIMUM 6" OF LOAM AND SEED.
 4. EXTEND LOAM AND SEED FROM EDGE OF WALL, OR EDGE OF BUTTRESS (ADD ALT. 1) DOWNSTREAM AT LEAST 15 FT OR LIMITS OF DISTURBANCE, WHICHEVER IS GREATER.
 5. SHOULD THE BUTTRESS BE INSTALLED, FULLY REPOINT THE EXISTING WALL FROM EL. 65.00 TO TOP OF WALL. MORTAR WORK FROM EL. 65.00 TO THE BOTTOM OF THE WALLS SHALL BE LIMITED TO FILLING THE GAPS BETWEEN THE STONES.
 6. SHOULD THE BUTTRESS NOT BE INSTALLED, FULLY REPOINT THE EXISTING WALL ACROSS ITS FULL EXPOSED HEIGHT.

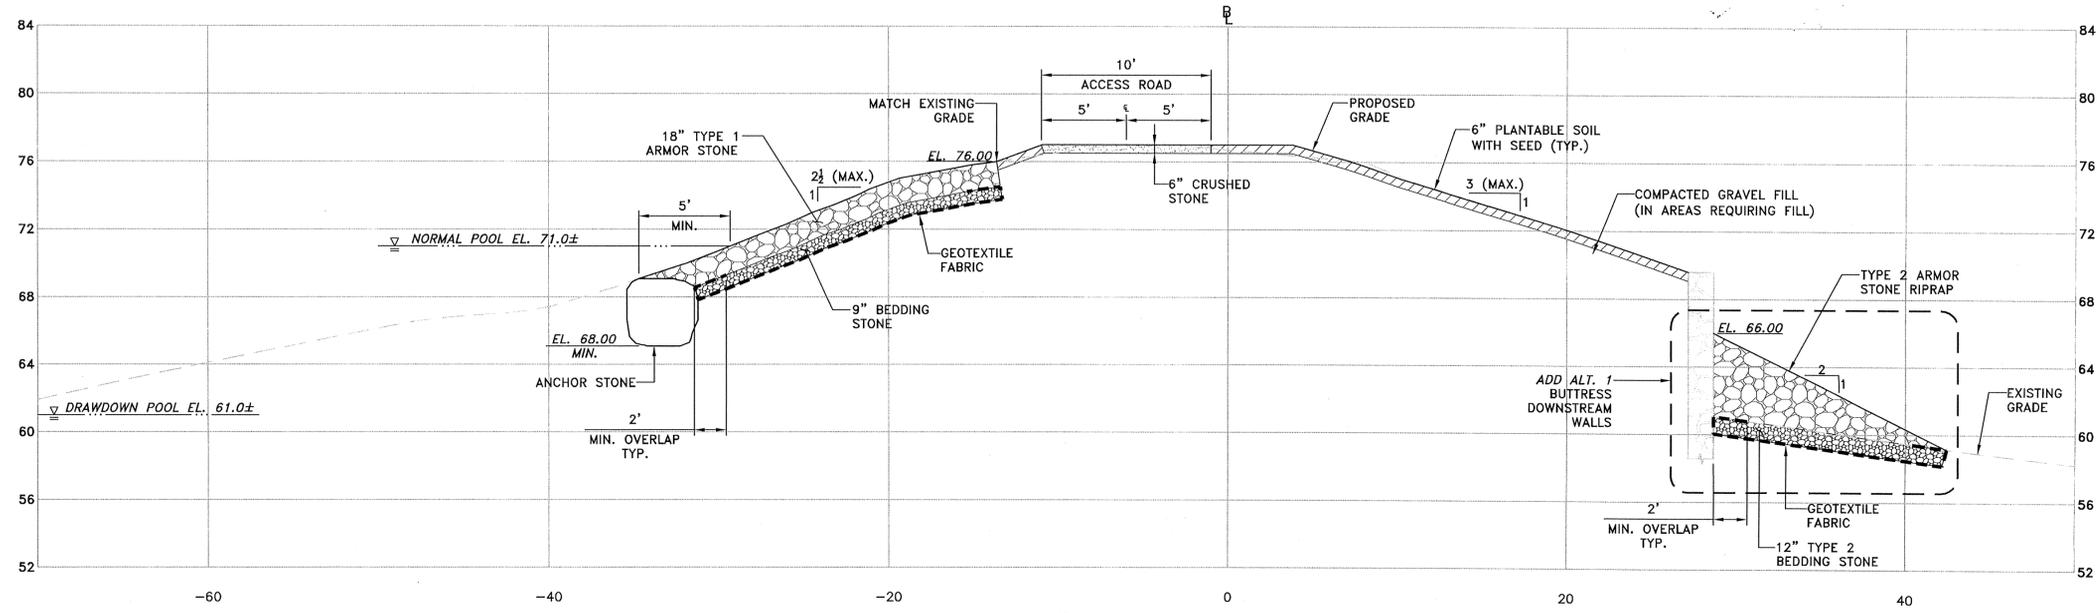

MAS Building & Bridge, Inc.
West Dudley Bridge Replacement
Dudley, MA

R.F.I. # Barney-002
DATE: 7/24/12

R.F.I. FORM

Engineer:
Pare Corporation
10 Lincoln Road, Suite 103
Foxboro, MA 02035

General Contractor:
MAS Building & Bridge, Inc.
P.O. 49
Franklin, MA 02038
Phone: 508-520-2277
Fax: 508-520-2276

This is a Request For Information/Clarification/Interpretation related to the Contract Documents/Specifications.

QUESTION:

Please refer to Section C on Sheet 6.0. MAS laid out the upstream apron and noticed an issue. The original dam structure is in conflict with the new 4'-0" x 2'-0" foundation wall. All but 6" of the width of the wall will land on the original dam structure. MAS would like to move the wall and apron upstream. Please advise.

Originated By: Fred Sorbo Information Required Not Later Than: 7/25/2012

REPLY: Date Received:

The proposed upstream vertical wall may be constructed immediately upstream of the existing upstream face of the spillway. A bond breaker shall be provided as indicated on the plans and the reinforcing steel shall be adjusted accordingly. The proposed spillway apron shall be elongated in the upstream direction to accommodate this change. The configuration of the downstream side of the spillway shall remain the same.

Response By: Andrea Judge Date: 7/24/12

MAS Building & Bridge, Inc.
Barney Pond Dam Improvements
Lincoln, RI

R.F.I. # Barney-002
DATE: 8/2/12

R.F.I. FORM

Engineer:
Pare Corporation
10 Lincoln Road, Suite 103
Foxboro, MA 02035

General Contractor:
MAS Building & Bridge, Inc.
P.O. 49
Franklin, MA 02038
Phone: 508-520-2277
Fax: 508-520-2276

This is a Request For Information/Clarification/Interpretation related to the Contract Documents/Specifications.

QUESTION:

Please refer to section C on drawing 6.0 and the attached sketch. MAS would like to move the vertical construction joint in the first lift of unreinforced concrete. The joint would be moved from the downstream separation joint to relieve the height of the concrete jumps from 2'-0" to 4'-0". This is for constructability purposes, moving the joint would make the forming more efficient. Also, MAS would propose moving the steel sheeting cutoff wall 1'-0" upstream, in order to keep it away from the joint. Please confirm this is acceptable.

Originated By: Fred Sorbo Information Required Not Later Than: 8/10/2012

REPLY: Date Received:

The joint can be shifted as requested with modifications to the RFI as follows:
1. Extend the bedding stone layer to the relocated joint as indicated on the marked up sketch (See Attached).
2. Relocate the cutoff sheeting such that the downstream face is 2 feet upstream of the relocated joint as indicated on the marked up sketch (See Attached).

Response By: D. Matheson Date: 8/3/12

MAS Building & Bridge, Inc.
Barney Pond Dam Improvements
Lincoln, RI

R.F.I. # Barney-009
DATE: 8/10/12

R.F.I. FORM

Engineer:
Pare Corporation
10 Lincoln Road, Suite 103
Foxboro, MA 02035

General Contractor:
MAS Building & Bridge, Inc.
P.O. 49
Franklin, MA 02038
Phone: 508-520-2277
Fax: 508-520-2276

This is a Request For Information/Clarification/Interpretation related to the Contract Documents/Specifications.

QUESTION:

Please refer to section C on drawing 6.0. The 4 corners of the scour pad were set up for control. From there the actual dimension from the scour pad to the existing spillway is 15'-6". At the base there is vertical timber lagging. On drawing 3.0 a note states to "R&D toe of existing spillway as needed." MAS is concerned that demolishing part of the spillway and having to remove the vertical lagging will compromise the existing structure. MAS proposes to leave the structure as is and decrease the 17'-6" dimension from the scour pad to the spillway to 15'-6". Please confirm this is acceptable.


Originated By: Fred Sorbo Information Required Not Later Than: 8/15/2012

REPLY: Date Received: 8/10/12

PAVE has run through stability analyses of the new spillway considering leaving the existing spillway toe in place and shortening up the upstream side of the proposed spillway base and has determined that the new spillway section satisfies stability requirements. This also takes into consideration the relocating of the cutoff sheeting per RFI No. 5. Therefore, the existing toe can remain in place with the decrease in spillway base dimension as requested.

Response By: David Matheson Date: 8/23/12

RFI # 005 Response

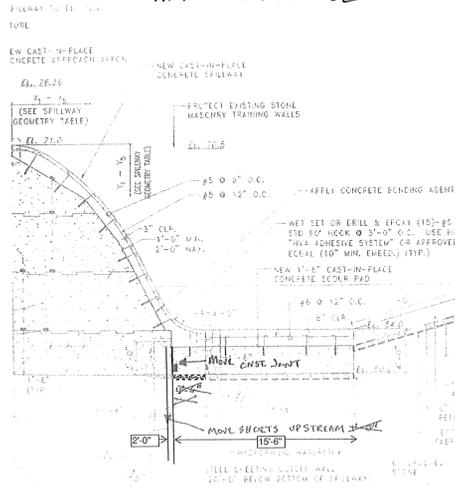

MAS Building & Bridge, Inc.
West Dudley Bridge Replacement
Dudley, MA

R.F.I. # Barney-002
DATE: 7/10/12

R.F.I. FORM

Engineer:
Pare Corporation
10 Lincoln Road, Suite 103
Foxboro, MA 02035

General Contractor:
MAS Building & Bridge, Inc.
P.O. 49
Franklin, MA 02038
Phone: 508-520-2277
Fax: 508-520-2276

This is a Request For Information/Clarification/Interpretation related to the Contract Documents/Specifications.

QUESTION:

Please refer to Section C on Sheet 6.0 and the attached sketch. MAS proposes to move the expansion joint at the crest of the spillway back up the apron to 1'-0" before the crest of the existing spillway. MAS would also like to remove the construction joint at the top of the apron and pour the apron and the 4'-0" foundation wall monolithically. MAS will use the following steps for this procedure: 1) Apply bond breaker to existing spillway. 2) Install overhangs on existing spillway at 4'-0" on center for 1'-0" overhang. 3) The overhang will remain and not be removed until MAS forms the top lift of unreinforced concrete. Once the overhangs are removed the bond breaker will be repaired. Please confirm this is acceptable.


Originated By: Fred Sorbo Information Required Not Later Than: 7/12/2012



REPLY: Date Received: 7/9/2012

The alternative approach is acceptable given the following:
1. The expansion joint is relocated providing a minimum bearing of 2'-0" on the mass concrete, as indicated on the attached sketch.
2. An additional #5 hooked bar @ 3'-0" O.C. is provided upstream of the relocated expansion joint, as indicated on the attached sketch.


Response By: Adam D. Cabral, P.E.

Date: 7/10/2012

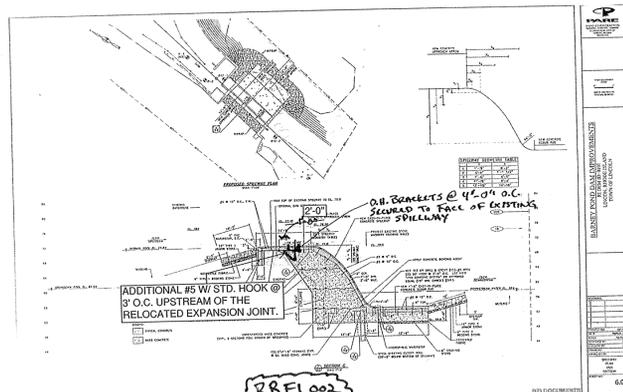

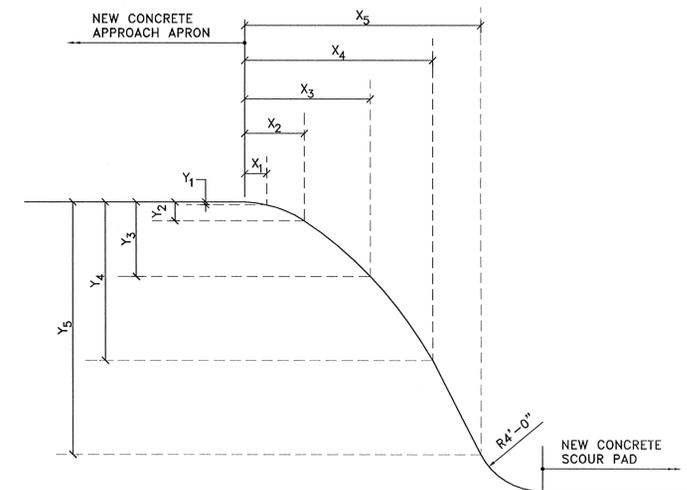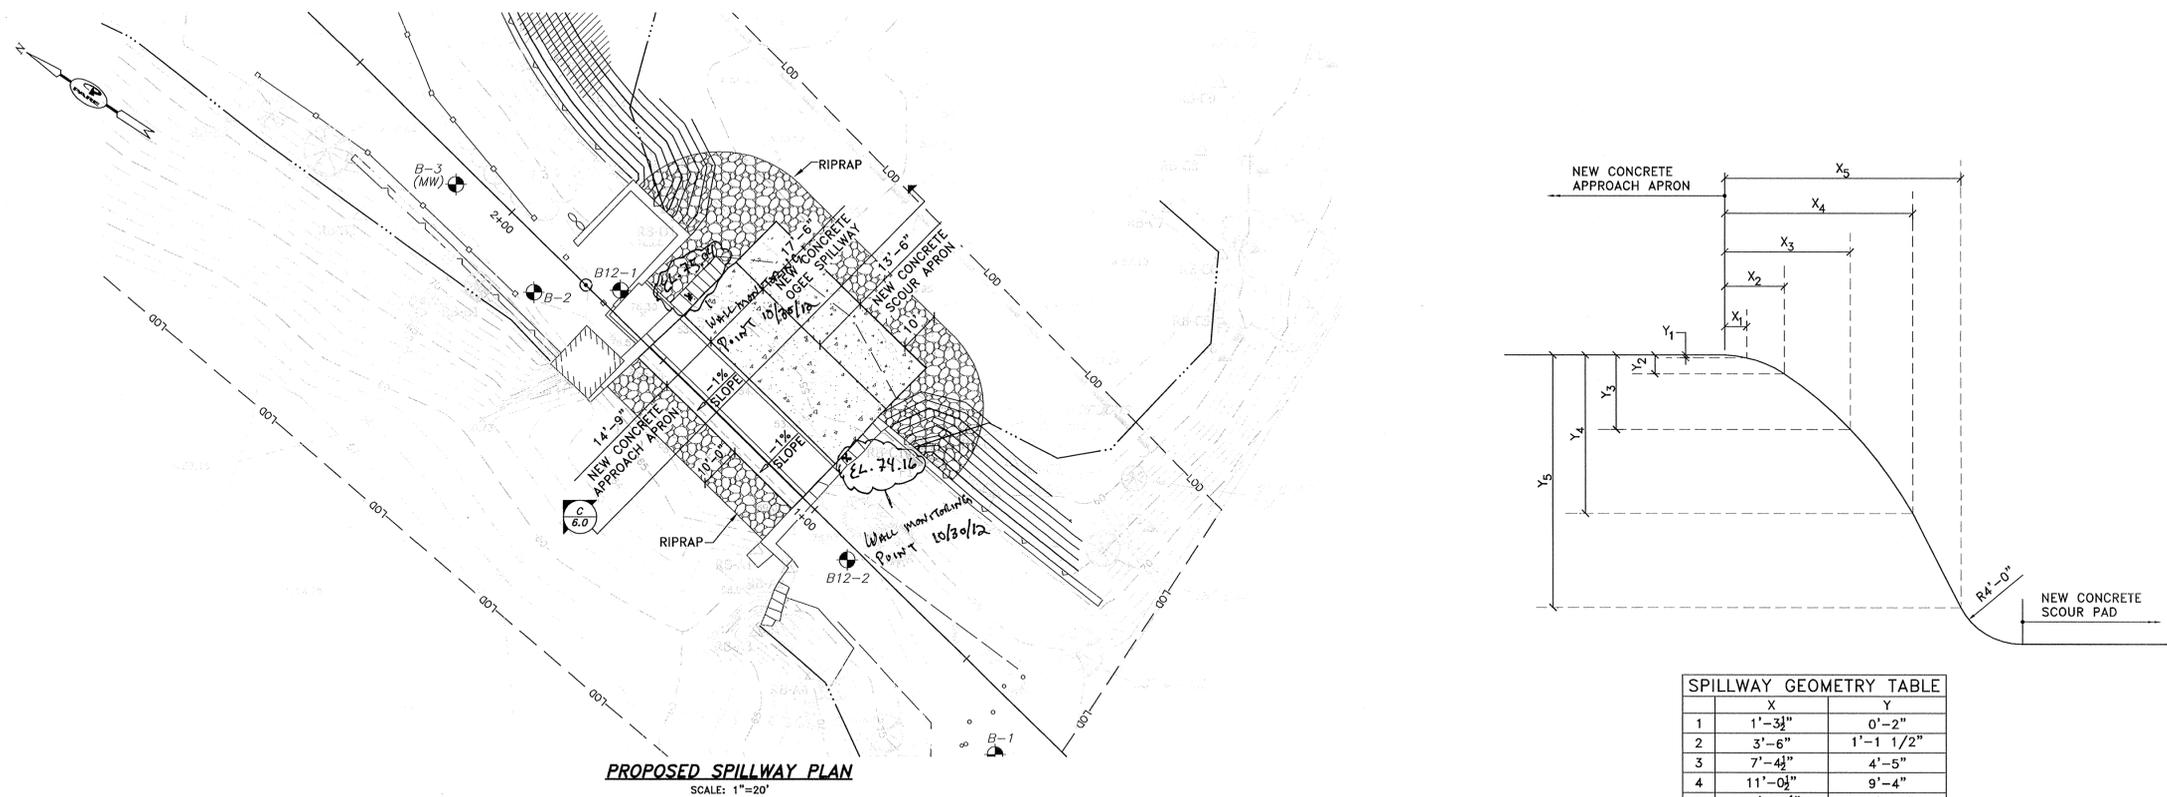

SPILLWAY GEOMETRY TABLE		
	X	Y
1	1'-3 3/4"	0'-2"
2	3'-6"	1'-1 1/2"
3	7'-4 1/2"	4'-5"
4	11'-0 1/2"	9'-4"
5	13'-10 1/2"	14'-10"

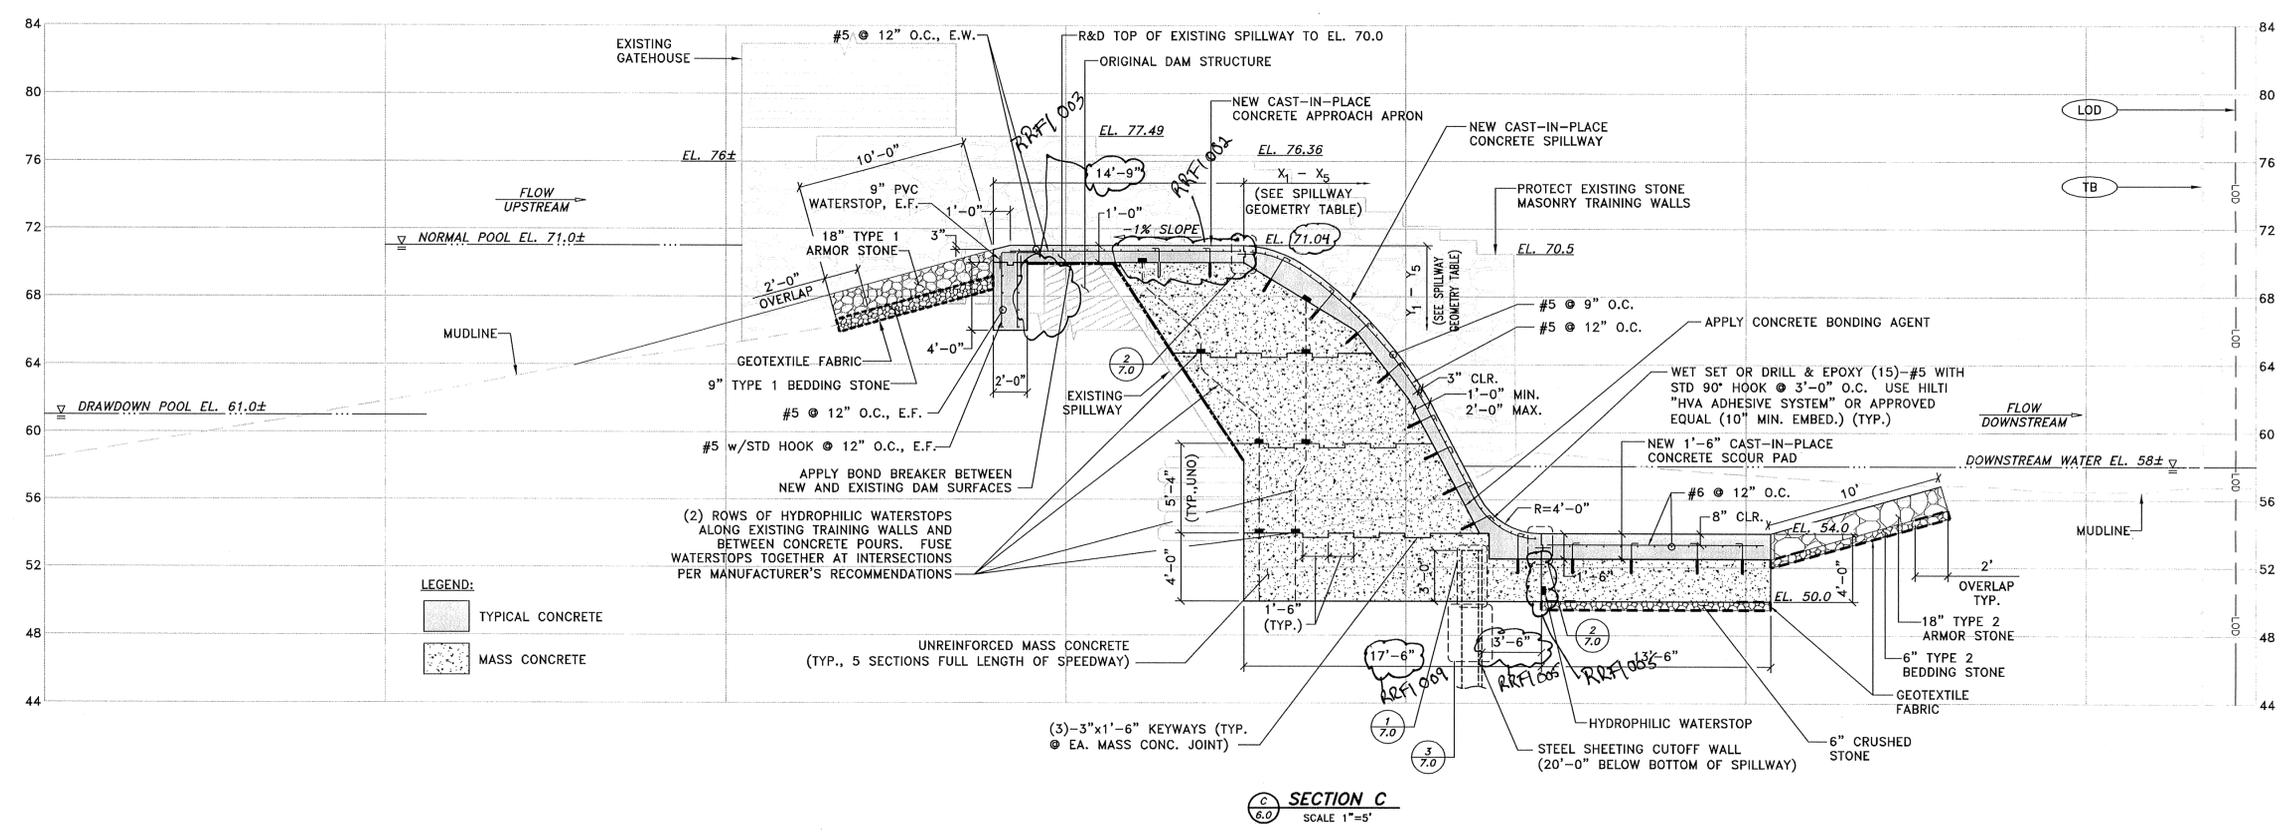

REVISIONS:

NO.	DESCRIPTION

PROJECT NO.: 08194.01
 DATE: MARCH, 2012
 SCALE: AS NOTED
 DESIGNED BY: DMM
 CHECKED BY: DMM
 DRAWN BY: JHG
 APPROVED BY: JMB

SPILLWAY
 PLAN
 AND
 SECTION

SHEET NO.: 6.0

MAS Building & Bridge, Inc.
Barney Pond Dam Improvements
Lincoln, RI

R.F.I. # Barney-004
DATE: 7/31/12

R.F.I. FORM

Owner:
Pine Corporation
10 Lincoln Road, Suite 103
Foxboro, MA 02035

General Contractor:
MAS Building & Bridge, Inc.
P.O. 49
Franklin, MA 02038
Phone: 508-520-2277
Fax: 508-520-2276

This is a Request For Information/Clarification/Interpretation related to the Contract Documents/Specifications.

QUESTION:
Please refer to Detail 28.0 on Sheet 7.0. When looking at the detail it shows a 9" water stop at 1/5L down from the top of concrete. At the upstream expansion joint L=12', therefore the 9" water stop will be 2.4 inches from the surface. MAS has concern that this will create spalling at this area. Please advise.

Originated By: Fred Sobbe Information Required Not Later Than: 7/31/2012

REPLY: 7/31/2012

The location of the water stop can be shifted down so that it is 4 inches below the top of the approach slab. In turn, the dowels can also be shifted down as well but no greater than 4 inches from the bottom of the slab.

Response By: David Matheson Date: 7/31/2012

Handwritten notes in a cloud shape:
7/31/12
2.4 inches from surface
spalling




BARNEY POND DAM IMPROVEMENTS
 RI DEM ID: 0101
 LINCOLN, RHODE ISLAND
 TOWN OF LINCOLN

REVISIONS:


NO.	DESCRIPTION

PROJECT NO.: 08194.01
 DATE: MARCH, 2012
 SCALE: AS NOTED
 DESIGNED BY: DMM
 CHECKED BY: DMM
 DRAWN BY: JHG
 APPROVED BY: JMB


LEFT
 LOW LEVEL OUTLET
 GATE
 EXISTING CONDITIONS
 SHEET NO.: **9.0**

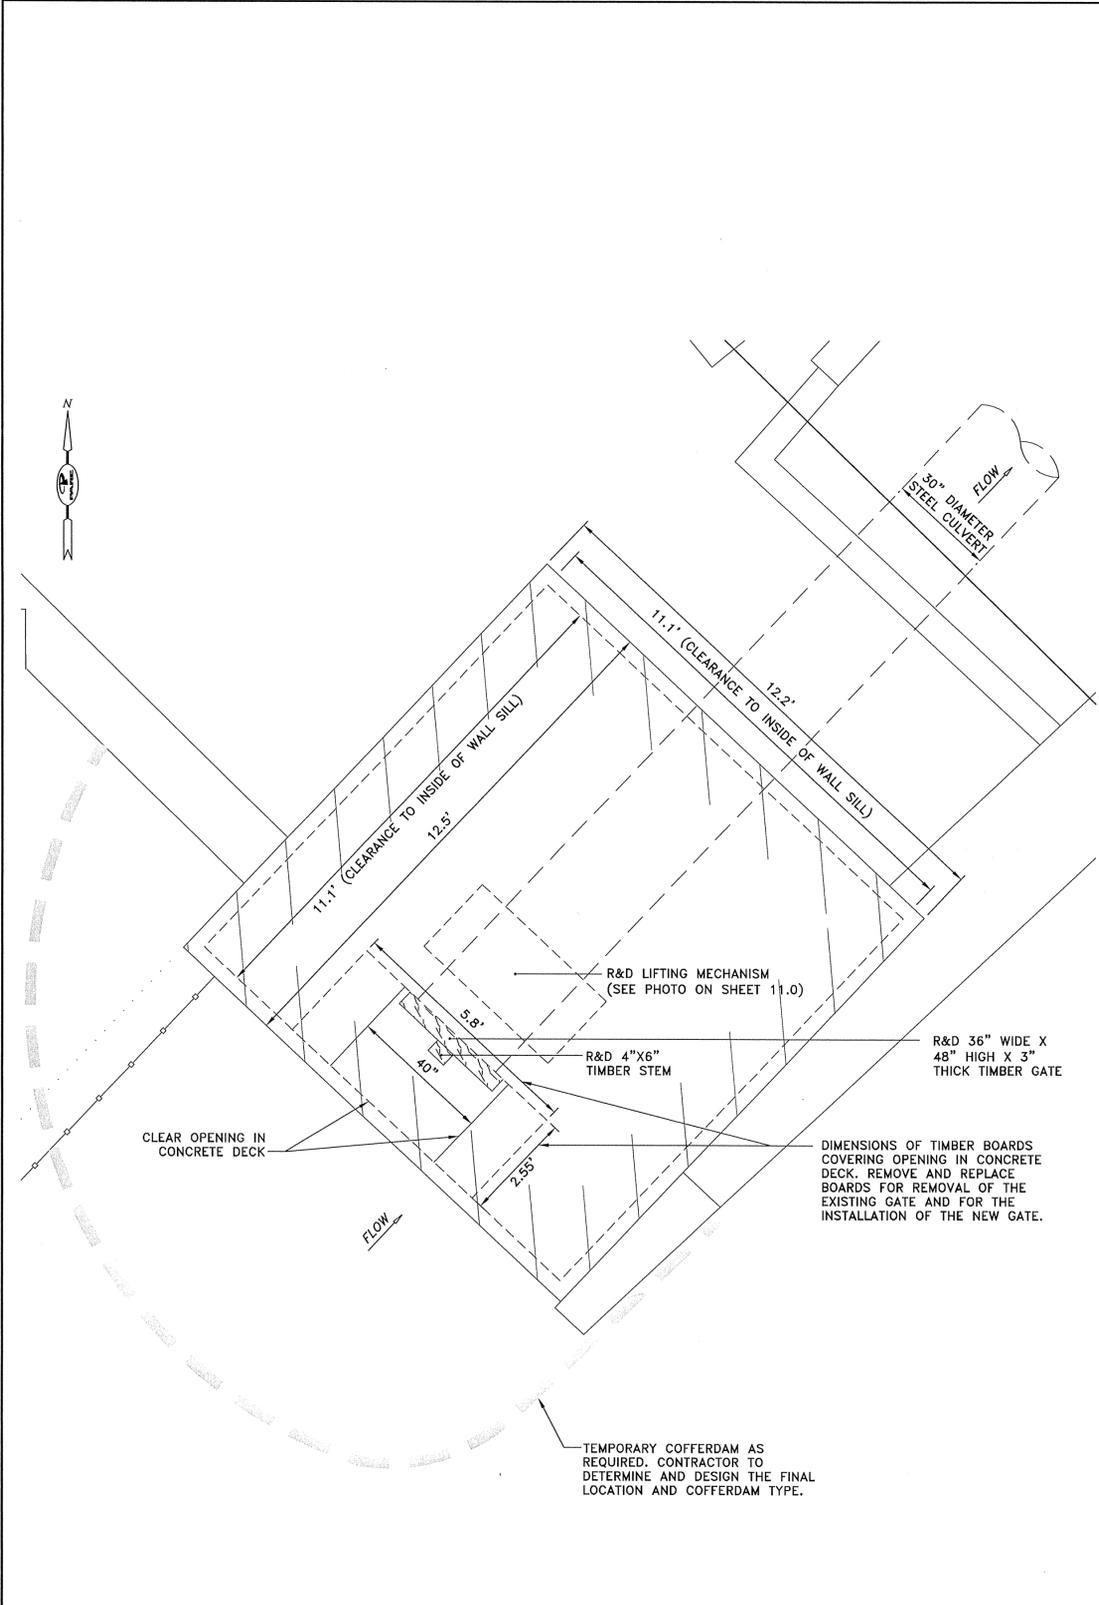

GATE HOUSE PLAN
 NOT TO SCALE

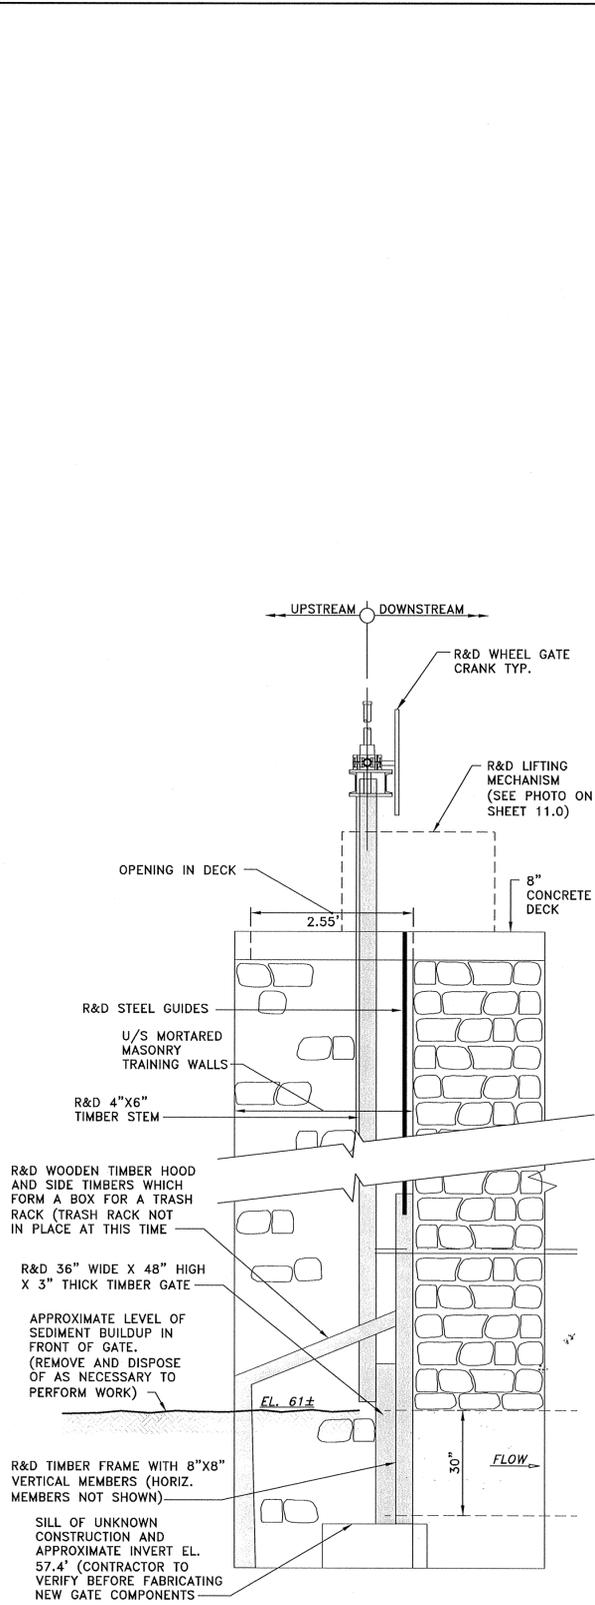

GATE HOUSE SECTION
 NOT TO SCALE

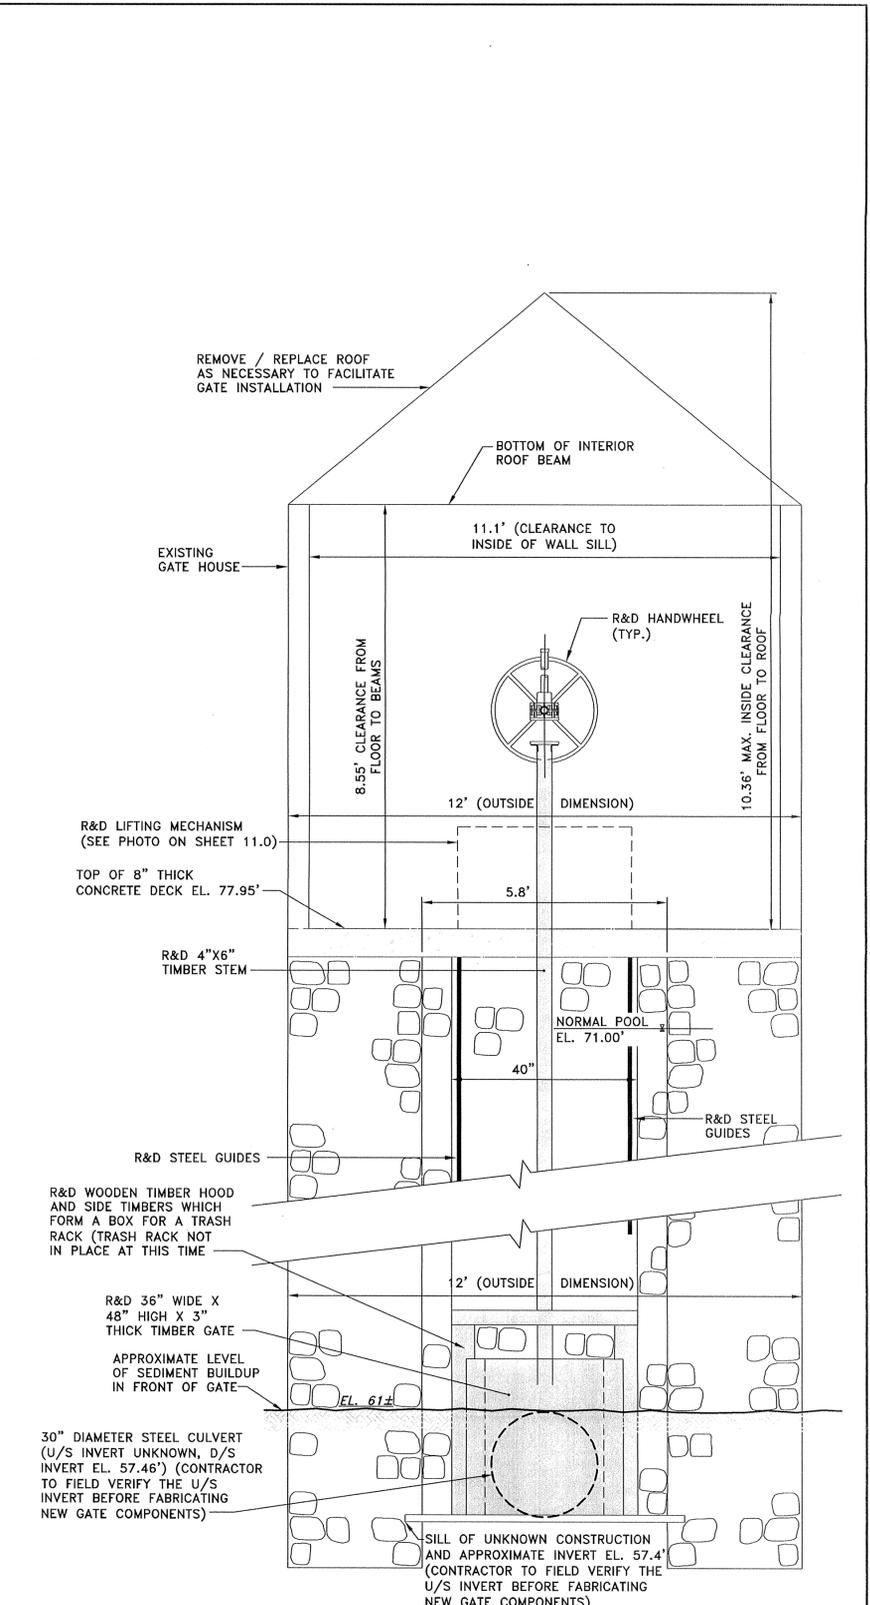

GATE HOUSE ELEVATION
 (UPSTREAM FACE)
 NOT TO SCALE

Z:\005\08 Jobs\08194.01 Barney Pond\Drawings\9.0 - Gate Details and Right Outlet.dwg

MAS Building & Bridge, Inc.
Barney Pond Dam Improvements
Lincoln, RI

R.F.I. # Barney-011
DATE: 9/12

R.F.I. FORM

Engineer
Pare Corporation
10 Lincoln Road, Suite 103
Foxboro, MA 02035

General Contractor
MAS Building & Bridge, Inc.
P.O. 49
Franklin, MA 02036
Phone: 508-520-2277
Fax: 508-520-2278

This is a Request For Information/Clarification/Interpretation related to the Contract Documents/Specifications.

QUESTION:

Please refer to the attached drawing. MAS has as built the gate and the attached sheet will show this. The scufal invert is at elevation 57.67' instead of 57.4' as shown on the plans. The sill will be set into place by using 6 to 10 inches of grout to lock it into place. Also, the existing finish floor elevation of the gate house is 77.89' instead of 77.50' as shown on the plans. Therefore, the approved gate that will be on site shortly is 4 inches taller than what the drawing shows. Please confirm that it is ok that the wheel for the gate sits 40" above finished floor, instead of the 30" shown on the plans.

Originated By: Fred Sorbo Information Required Not Later Than: 9/17/2012

REPLY: Date Received:

Per Item 12.003 of Progress Meeting No. 13 minutes, the Town does not have an issue with the new gate wheel being set 4 inches higher than shown on the Contract Documents.

Response By: David Matheson Date: 9/17/12

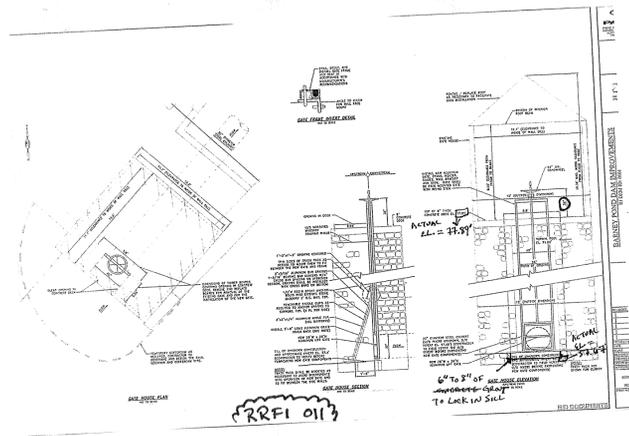


EXHIBIT E

PRE-BID MEETING SIGN IN SHEET

Barney Pond Dam Pedestrian Bridge RFP #2013-22 Mandatory Pre-Bid Meeting May 23, 2013

Name	Company Name	Address	Phone #	Email Address
Gregory Kornichuk	JH Lynch & Sons	50 Lynch Place Cumberland, RI	401-333-4300	Sales@jhlynch.com
DAVID NICODEMUS	H.K. & S CONSTRUCTION HOLDING CORP	51 AMERICAS CUP NEWPORT, RI 02840	401-847-7350	INFO@HKANDS.COM
William Tyrrell	Northern Construction Service, LLC	775 Pleasant St, unit 11 Weymouth, MA 02199	781-340-9440	WTYRRELL@NORTHERNCONSTRUCTION.COM
Dave Allan	Chesterfield Assoc.	123 W. Shone Road 04578 Westport Island ME	207-882-5400	boathouse@gwir.net
David Courtois	Adamsdale concrete	551 Weeden St, Pawtucket	401-722-6725	d.courtois@verizon.net
Wendy KerKhoff	Thielsch Engineering	195 Frances Ave. Cranston, RI 02910	401-996-3514	WKerKhoff@Thielsch.com
GAELEN MAGEE	MAS BUILDING & BRIDGE	18 SHARON AVE NORFOLK, MA 02056	508 520 2277	GMAGEE@MASBUILDINGANDBRIDGE.COM
Sal Torigiano	Tower Const Corp	2158 Painted Pine CRANSTON RI 02901	401-943-0110	ESTIMATING@TowerConstCorp.com
BRIAN G. IANNUCCILLO	RP IANNUCCILLO & SONS CONST	70 CALVERLEY ST PROVIDENCE, RI 02908	401-351-8877	brian@RPIANNUCCILLO.COM
Rich LeBlanc	S & R Corp	Lowell MA	978-441-2000	RLeBlanc@sandocorp.com
Dave Matheson	Pare Corporation	10 Lincoln Rd., Suite 103 Foxboro, MA 02035	508-543-1755	Dmatheson@parecorp.com

Addendum Acknowledgement Receipt

**Barney Pond Dam – Pedestrian Bridge
RFP 2013-22**

Instructions: Return signed Addendum Acknowledgement Receipt to the following:

Leslie C. Quish
lquish@lincolnri.org
Fax: 401-753-7119

I hereby acknowledge receipt of Addendum Number 1

LEGAL NAME OF BIDDER

ACKNOWLEDGED BY (SIGNATURE)

ACKNOWLEDGED BY (PRINTED NAME)

DATE